
## ST. CLAIR COUNTY, MICHIGAN OFFICIAL GOVERNMENT CORNER



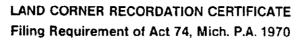

L	ocated In:	Corner Code ≠≠	1.		_
	Clyde Twp. T7N R16E. T R	D-13		REGISTAL -4	
<ol> <li>Property Controlling S</li> <li>in Section S</li> <li>Miscellaneous S</li> </ol>	T R T R T R T R	Leg. 2	Register of I	Deeds Stamp & L	ile Number
4. Lot No, Recorded Pla	at		— АВ	CDEFG	ніјкі
5. Private Claims	:		2 6-	54	3 - 2 - 1
Daniel E. Johnson	June 2	23, 95	3 7 -	89	101112
I, in a field side hereby certify that under requirements of in lines 1 and 2 above were in conformance current manual of survey instructions of the Management or by a decree of a Court of Law above were in conformance with the rules of Court of Law; established, re-established expressed below:  NOTE: Not more than 1 corner, may I	P.A. 74, Michigan P.A. of the with regulations and the United States Departm and/or that the corner partment of the the Michigan Board of the monumented, re-mon	f 1970, the corner points me rules therefore as require tent of the Interior, Bureau points mentioned in lines 3, Land Surveyors or by a Dec pnumented, recovered, fo	entioned d in the of Land 7 4 and 5 8 19 2 2 2 2 2 2 2 2 2 2 2 2 2 2 2 2 2 2	29 28 2	22 — 23 — 24 27 — 26 — 25
			12 -31-	32 33 3	35 36
A. Description of original monument an	d accessories and/or	subsequent restoration:	ST	ATE PLAIN COC	RDINATES
LIBER 007 PAGE	372				
			<b>-</b>		
			1		
B. Description of corner evidence found LIBER 007 PAGE		ed in restoring or reestab		OF MICH	In his
			** # 8.6 S	JOHNSON LAND SURVEYOR 13754	W. 108 .
C. Description of monument for corner Set with 2" dia. aluminu (in Monument Box)	and accessories estal m cap inscribed	blished to perpetuate localing and structure of the countries of the count	ating the position of the ty Official Co	e company	agnet
Located on the true Town S 15°W 54.85' to set PK S 30°E 85.64' to set PK N 13°E 50.78' to set PK N 72°W 144.57' to set PK WEST 2627.51' to SW corn EAST 2636.22' to SE corn	ship Line nail w/county nail w/county nail w/county nail w/county er Section 32,	remon tag in WSW remon tag in E remon tag in SW T7N-R16E	side of power   side of 12" Mg	pole aple Tree	
Signed by	Damel	//	Date <u>June</u>	23, 1995	
Surveyor's Michigan License No.	Daniel E. #13754	Johnson		PA 345-1990 Peer commit	TEE
APPROVED AS AN OFFICIAL GOVERN	NMENT CORNER BY	ST. ODAIR COUNTY:	APP . 7-31	ROVED <u>6-10</u> -95	-94 Dan
St. Clair County Land Survey			•	Date	
Surveyor's Michigan License No	<b>‡</b> 13754		LIBER	$008_{PAGE}$ (	53