

RECEIVED

ST. CLAIR COUNTY, MICHIGAN
OFFICIAL GOVERNMENT CORNER



SEP 20 PM 2:23 LAND CORNER RECORDATION CERTIFICATE
Filing Requirement of Act 74, Mich. P.A. 1970

	Located In:	Corner Code #
	Clyde Township	
1. Public Land Survey	T <u>7N</u> R <u>16E</u>	<u>F-13</u>
	T _____ R _____	_____
	T _____ R _____	_____
	T _____ R _____	_____
2. Property Controlling in Section	S _____ T _____ R _____	<u>Sept</u>
	S _____ T _____ R _____	_____
3. Miscellaneous Property in Sec.	S _____ T _____ R _____	_____
	S _____ T _____ R _____	_____

Register of Deeds Stamp & File Number

4. Lot No. _____, Recorded Plat _____
5. Private Claims _____

I, John C. Niederhauser, in a field survey on January 25, 19 94, do hereby certify that under requirements of P.A. 74, Michigan P.A. of 1970, the corner points mentioned in lines 1 and 2 above were in conformance with regulations and rules therefore as required in the current manual of survey instructions of the United States Department of the Interior, Bureau of Land Management or by a decree of a Court of Law and/or that the corner points mentioned in lines 3, 4 and 5 above were in conformance with the rules of the Michigan Board of Land Surveyors or by a Decree of a Court of Law; established, re-established, monumented, re-monumented, recovered, found as expressed below:

A	B	C	D	E	F	G	H	I	J	K	L	M
2	6	5	4	3	2							
3												
4	7	8	9	10	11	12						
5												
6	18	17	16	15	14	13						
7												
8	19	20	21	22	23	24						
9												
10	30	29	28	27	26	25						
11												
12	31	32	33	34	35	36						
13												

NOTE: Not more than 1 corner, may be recorded on this certificate.

A. Description of original monument and accessories and/or subsequent restoration:

Wood post set by Joseph Wampler, 1822.
Ford axle listed on Old Highway Plans. Masonry nail listed on recorded survey Liber 1, page 366 and on recorded survey Liber 2, page 100. Corner reset with P.K. nail by G. James and recorded in Liber 1, page 935. P.K. nail listed on B. Kreger survey recorded Liber 10, page 188.

STATE PLAIN COORDINATES

N. _____

E. _____

ELEVATION _____

B. Description of corner evidence found and/or method applied in restoring or reestablishing corner:

Found P.K. nail on centerline of existing Lapeer Road pavement. Corner witnesses previously recorded were not found except for "N. 46.7' to spike in power pole" listed on corner certificate Liber 1, page 935 and survey Liber 10, page 188. Corner is in line with old fence line to north. Reference to 1930 Michigan Department of Transportation road plans does not check with current field measurements. Verified corner location from recorded surveys Liber 1, page 366, Liber 2, page 479, Liber 2, page 100 and Liber 10, page 188.

C. Description of monument for corner and accessories established to perpetuate locating the position of the corner:


P.K. nail on centerline of existing Lapeer Road pavement. Located on the true Township line.
NORTH 46.58' to set P.K. nail with county remon tag in W. side of power pole
N 30°W 59.88' to set P.K. nail with county remon tag in E. side 6" elm tree
S 60°W 120.48' to set P.K. nail with county remon tag in N.W. side power pole
S 70°E 128.45' to set P.K. nail with county remon tag in N.E. side power pole
WEST 2636.56' to S.W. corner Section 33, T7N-R16E
EAST 2632.78' to S.E. corner Section 33, T7N-R16E

Signed by John C. Niederhauser
Surveyor's Michigan License No. 24608

Date May 19 1994

PA 345-1990
PEER COMMITTEE

APPROVED 6-10-94

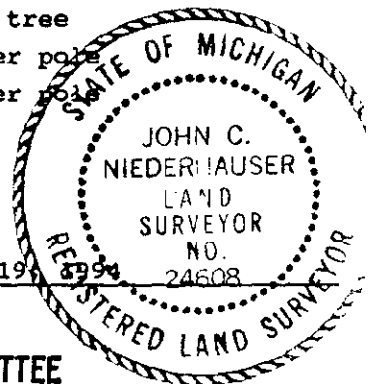

APPROVED AS AN OFFICIAL GOVERNMENT CORNER BY ST. CLAIR COUNTY:

Signed By: _____
St. Clair County Land Surveyor

Surveyor's Michigan License No. _____

Date _____
LIBER 007 PAGE 370