ST. CLAIR COUNTY, MICHIGAN
OFFICIAL GOVERNMENT CORNER

LAND CORNER RECORDATION CERTIFICATE
Filing Requirement of Act 74, Mich. P.A. 1970

	Located In:	Corner Code #
1. Public Land Survey	T ____ R 7N. 16E.	Clyde Twp. H-13
	T ____ R ____	
	T ____ R ____	
	T ____ R ____	
2. Property Controlling	S ____ T ____ R ____	
in Section	S ____ T ____ R ____	Seg. 2
3. Miscellaneous	S ____ T ____ R ____	
Property in Sec.	S ____ T ____ R ____	

RECEIVED 1995 AUG -4 AM 10:13 REGISTER OF DEEDS ST. CLAIR COUNTY

Register of Deeds Stamp & File Number

4. Lot No. _____ , Recorded Plat _____
5. Private Claims _____

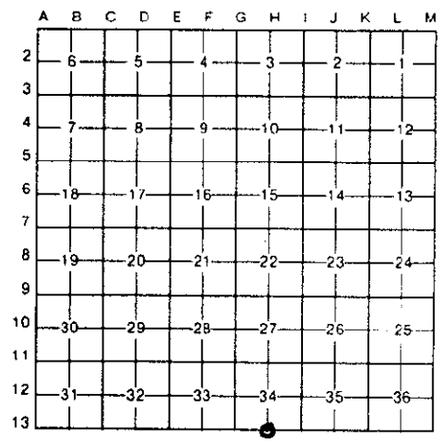

STATE PLAIN COORDINATES

N. _____

E. _____

ELEVATION _____

I, Daniel E. Johnson, in a field survey on June 23, 95, 19 _____ . do hereby certify that under requirements of P.A. 74, Michigan P.A. of 1970, the corner points mentioned in lines 1 and 2 above were in conformance with regulations and rules therefore as required in the current manual of survey instructions of the United States Department of the Interior, Bureau of Land Management or by a decree of a Court of Law and/or that the corner points mentioned in lines 3, 4 and 5 above were in conformance with the rules of the Michigan Board of Land Surveyors or by a Decree of a Court of Law; established, re-established, monumented, re-monumented, recovered, found as expressed below:

NOTE: Not more than 1 corner, may be recorded on this certificate.

A. Description of original monument and accessories and/or subsequent restoration:

LIBER 007 PAGE 368

B. Description of corner evidence found and/or method applied in restoring or reestablishing corner:

LIBER 007 PAGE 368

STATE OF MICHIGAN
DANIEL E. JOHNSON
LAND SURVEYOR
13754
REGISTERED LAND SURVEYOR

C. Description of monument for corner and accessories established to perpetuate locating the position of the corner:

Set with 2" dia. aluminum cap inscribed "St. Clair County Official Corner" with magnet (in Monument Box) on a
5/8" iron rod in monument box, 1.5' S of existing centerline of Lapeer Rd. pavement.
Located on the true Township line.
N 05°E 47.30' to set PK nail w/county remon tag in E side of power pole
S 60°E 116.00' to set PK nail w/county remon tag in NE side of power pole
S 60°W 165.52' to set PK nail w/county remon tag in NW side of power pole
N 60°W 112.59' to set PK nail w/county remon tag in SW side of power pole
NORTH 1.5' to centerline of existing Lapeer Road Pavement
WEST 2632.67' to S.W. corner Section 34, T7N-R16E
EAST 2654.98' to S.E. corner Section 34, T7N-R16E

Signed by Daniel E. Johnson Date June 23, 1995

Surveyor's Michigan License No. #13754

PA 345-1990
PEER COMMITTEE
APPROVED 6-10-94

APPROVED AS AN OFFICIAL GOVERNMENT CORNER BY ST. CLAIR COUNTY:

Signed By: Daniel E. Johnson : 7/31/95
St. Clair County Land Surveyor Date

Surveyor's Michigan License No. #13754

LIBER 008 PAGE 87