

# ST. CLAIR COUNTY, MICHIGAN OFFICIAL GOVERNMENT CORNER



## LAND CORNER RECORDATION CERTIFICATE Filing Requirement of Act 74, Mich. P.A. 1970

Located In: Clyde Twp. Corner Code # M-13

- |                                    |                            |              |
|------------------------------------|----------------------------|--------------|
| 1. Public Land Survey              | T <u>7N.</u> R <u>16E.</u> | <u>M-13</u>  |
|                                    | T _____ R _____            | _____        |
|                                    | T _____ R _____            | _____        |
|                                    | T _____ R _____            | _____        |
| 2. Property Controlling in Section | S _____ T _____ R _____    | <u>Seg 2</u> |
|                                    | S _____ T _____ R _____    | _____        |
| 3. Miscellaneous Property in Sec.  | S _____ T _____ R _____    | _____        |
|                                    | S _____ T _____ R _____    | _____        |

REGISTER OF DEEDS  
 ST. CLAIR COUNTY  
 1995 AUG -4 AM 10:13  
 RECEIVED

Register of Deeds Stamp & File Number

4. Lot No. \_\_\_\_\_, Recorded Plat \_\_\_\_\_
5. Private Claims \_\_\_\_\_

Daniel E. Johnson                      May 25,                      95

I, \_\_\_\_\_, in a field survey on \_\_\_\_\_, 19\_\_\_\_, do hereby certify that under requirements of P.A. 74, Michigan P.A. of 1970, the corner points mentioned in lines 1 and 2 above were in conformance with regulations and rules therefore as required in the current manual of survey instructions of the United States Department of the Interior, Bureau of Land Management or by a decree of a Court of Law and/or that the corner points mentioned in lines 3, 4 and 5 above were in conformance with the rules of the Michigan Board of Land Surveyors or by a Decree of a Court of Law; established, re-established, monumented, re-monumented, recovered, found as expressed below:

**NOTE: Not more than 1 corner, may be recorded on this certificate.**

A. Description of original monument and accessories and/or subsequent restoration:

**LIBER 007 PAGE 363**


STATE PLAIN COORDINATES

N. \_\_\_\_\_

E. \_\_\_\_\_

B. Description of corner evidence found and/or method applied in restoring or reestablishing corner:

**LIBER 007 PAGE 363**

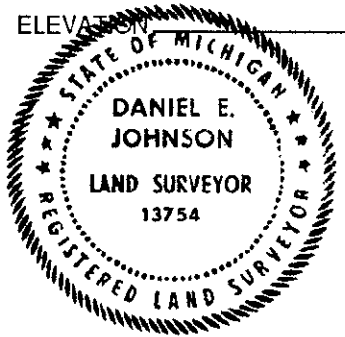

C. Description of monument for corner and accessories established to perpetuate locating the position of the corner:

Set 1/2" x 18" Rerod with 2" dia. aluminum cap inscribed "St. Clair County Official Corner" with magnet (In Monument Box)

on existing centerline of W Water St. pvmt. Located on the true

Township line.

- S 04°W 30.68' to set PK nail w/county remon tag in E side of power pole
- N 04°W 33.68' to set PK nail w/county remon tag in W side of power pole
- N 76°E 135.23' to set PK nail w/county remon tag in SE side of power pole
- N 77°W 151.70' to set PK nail w/county remon tag in NE side of power pole
- WEST 2632.43' to S 1/4 corner of Section 36, T7N-R16E
- EAST 2648.66' to S 1/4 corner of Section 31, T7N-R17E

Signed by Daniel E. Johnson                      Date May 25, 1995

Surveyor's Michigan License No. #13754

PA 345-1990  
PEER COMMITTEE

APPROVED 6-10-94 Dan

APPROVED AS AN OFFICIAL GOVERNMENT CORNER BY ST. CLAIR COUNTY:

Signed By: Daniel E. Johnson                      Date 7/31/95

St. Clair County Land Surveyor Daniel E. Johnson

Surveyor's Michigan License No. #13754

LIBER 008 PAGE 92