

ST. CLAIR COUNTY, MICHIGAN OFFICIAL GOVERNMENT CORNER



LAND CORNER RECORDATION CERTIFICATE Filing Requirement of Act 74, Mich. P.A. 1970

Located In: Clyde Twp. Corner Code J-13

- | | | |
|------------------------------------|----------------------------|--------------|
| 1. Public Land Survey | T <u>7N.</u> R <u>16E.</u> | <u>J-13</u> |
| | T _____ R _____ | _____ |
| | T _____ R _____ | _____ |
| | T _____ R _____ | _____ |
| 2. Property Controlling in Section | S _____ T _____ R _____ | <u>Leg 2</u> |
| | S _____ T _____ R _____ | _____ |
| 3. Miscellaneous Property in Sec. | S _____ T _____ R _____ | _____ |
| | S _____ T _____ R _____ | _____ |

RECEIVED
REGISTER OF DEEDS
ST. CLAIR COUNTY
1995 AUG - 4 AM 10:43
Register of Deeds Stamp & File Number

4. Lot No. _____, Recorded Plat _____
5. Private Claims _____

	A	B	C	D	E	F	G	H	I	J	K	L	M
2	6	5	4	3	2	1							
3													
4	7	8	9	10	11	12							
5													
6	18	17	16	15	14	13							
7													
8	19	20	21	22	23	24							
9													
10	30	29	28	27	26	25							
11													
12	31	32	33	34	35	36							
13													

I, Daniel E. Johnson May 26, 95
in a field survey on _____, 19____
do hereby certify that under requirements of P.A. 74, Michigan P.A. of 1970, the corner points mentioned in lines 1 and 2 above were in conformance with regulations and rules therefore as required in the current manual of survey instructions of the United States Department of the Interior, Bureau of Land Management or by a decree of a Court of Law and/or that the corner points mentioned in lines 3, 4 and 5 above were in conformance with the rules of the Michigan Board of Land Surveyors or by a Decree of a Court of Law; established, re-established, monumented, re-monumented, recovered, found as expressed below:

NOTE: Not more than 1 corner, may be recorded on this certificate.

A. Description of original monument and accessories and/or subsequent restoration:

LIBER 007 PAGE 366

STATE PLAIN COORDINATES


N. _____

E. _____

ELEVATION _____

B. Description of corner evidence found and/or method applied in restoring or reestablishing corner:

LIBER 007 PAGE 366

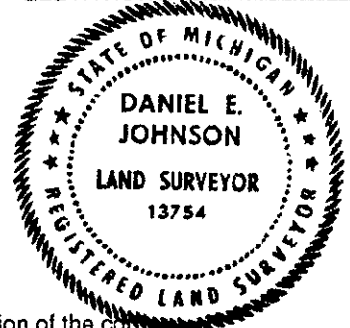

C. Description of monument for corner and accessories established to perpetuate locating the position of the corner:
Set with 2" dia. aluminum cap inscribed "St. Clair County Official Corner" with magnet on a Capped 1/2" rerod #24608. Located on the True Township line.
S. 6.42' to set PK nail w/county remon tag in NW side 12" Wild Cherry Tree
N.E. 26.75' to set PK nail w/county remon tag in NW side 10" Ash Tree
E. 24.62' to set PK nail w/county remon tag in N side 6" Wild Cherry Tree
W. 28.50' to set PK nail w/county remon tag in N side 6" Thorn Tree
S.E. 52.0' to 2' wide drainage swale running N & S
WEST 2620.58' to the SW corner of Section 35, T7N-R16E
EAST 2620.58' to the SE corner of Section 35, T7N-R16E

Signed by Daniel E. Johnson Date May 26, 1995
Daniel E. Johnson
Surveyor's Michigan License No. #13754

PA 345-1990
PEER COMMITTEE

APPROVED AS AN OFFICIAL GOVERNMENT CORNER BY ST. CLAIR COUNTY:
SIGNED BY: Daniel E. Johnson : 7-31-95
St. Clair County Land Surveyor Daniel E. Johnson Date
Surveyor's Michigan License No. #13754