

ST. CLAIR COUNTY, MICHIGAN OFFICIAL GOVERNMENT CORNER



LAND CORNER RECORDATION CERTIFICATE Filing Requirement of Act 74, Mich. P.A. 1970

Located In: _____ Corner Code # _____

- | | | |
|------------------------------------|--|---------------------------|
| 1. Public Land Survey | Clyde Twp.
T <u>7N.</u> R <u>16E.</u> | Corner Code # <u>A-13</u> |
| | T _____ R _____ | _____ |
| | T _____ R _____ | _____ |
| | T _____ R _____ | _____ |
| 2. Property Controlling in Section | S _____ T _____ R _____ | <u>Sec 2</u> |
| | S _____ T _____ R _____ | _____ |
| 3. Miscellaneous Property in Sec. | S _____ T _____ R _____ | _____ |
| | S _____ T _____ R _____ | _____ |

RECEIVED
 REGISTER OF DEEDS
 ST. CLAIR COUNTY
 1995 APR -4 AM 10:12

Register of Deeds Stamp & File Number

4. Lot No. _____, Recorded Plat _____
5. Private Claims _____

	A	B	C	D	E	F	G	H	I	J	K	L	M
2	6	5	4	3	2	1							
3													
4	7	8	9	10	11	12							
5													
6	18	17	16	15	14	13							
7													
8	19	20	21	22	23	24							
9													
10	30	29	28	27	26	25							
11													
12	31	32	33	34	35	36							
13													

Daniel E. Johnson May 26, 95
 I, _____, in a field survey on _____, 19____,
 do hereby certify that under requirements of P.A. 74, Michigan P.A. of 1970, the corner points mentioned in lines 1 and 2 above were in conformance with regulations and rules therefore as required in the current manual of survey instructions of the United States Department of the Interior, Bureau of Land Management or by a decree of a Court of Law and/or that the corner points mentioned in lines 3, 4 and 5 above were in conformance with the rules of the Michigan Board of Land Surveyors or by a Decree of a Court of Law; established, re-established, monumented, re-monumented, recovered, found as expressed below:

NOTE: Not more than 1 corner, may be recorded on this certificate.

A. Description of original monument and accessories and/or subsequent restoration:

LIBER 007 PAGE 134

STATE PLAIN COORDINATES


N. _____

E. _____

ELEVATION _____

B. Description of corner evidence found and/or method applied in restoring or reestablishing corner:

LIBER 007 PAGE 134

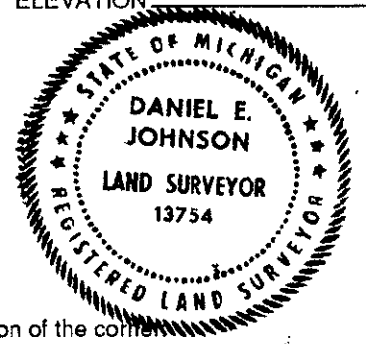

C. Description of monument for corner and accessories established to perpetuate locating the position of the corner:
 Set 1/2 x 42" Rerod with 2" dia. aluminum cap inscribed "St. Clair County Official Corner" with magnet

on a
1" Iron in Monument Box

- NW 76.85' to set PK and County Tag in D.E.P.
- SE 83.90' to set PK and County Tag in 36" Oak
- SW 76.45' to set PK and County Tag in D.E.P.
- NE 120.70' to set PK and County Tag in D.E.P.

(Corner is on centerline of existing Lapeer Rd. pavement)
 Corner common to SE Corner Section 36 T7N, R15E

Signed by _____ Date May 26, 1995

Surveyor's Michigan License No. Daniel E. Johnson
#13754

PA 345-1990
 PEER COMMITTEE

APPROVED 12-7-93

APPROVED AS AN OFFICIAL GOVERNMENT CORNER BY ST. CLAIR COUNTY:

Signed By: Daniel E. Johnson : 7-31-95
 St. Clair County Land Surveyor Daniel E. Johnson Date
#13754

Surveyor's Michigan License No. _____