

**ST. CLAIR COUNTY, MICHIGAN  
OFFICIAL GOVERNMENT CORNER**



**LAND CORNER RECORDATION CERTIFICATE  
Filing Requirement of Act 74, Mich. P.A. 1970**

Located In: \_\_\_\_\_ Corner Code # \_\_\_\_\_

**Clyde Twp.**

- |                                    |                            |              |
|------------------------------------|----------------------------|--------------|
| 1. Public Land Survey              | T <u>7N.</u> R <u>16E.</u> | <u>E-13</u>  |
|                                    | T _____ R _____            | _____        |
|                                    | T _____ R _____            | _____        |
|                                    | T _____ R _____            | _____        |
| 2. Property Controlling in Section | S _____ T _____ R _____    | <u>Seg 2</u> |
|                                    | S _____ T _____ R _____    | _____        |
| 3. Miscellaneous Property in Sec.  | S _____ T _____ R _____    | _____        |
|                                    | S _____ T _____ R _____    | _____        |

RECEIVED  
REGISTERED  
ST. CLAIR COUNTY  
1995 AUG -4 AM 10:13  
Register of Deeds Stamp & File Number

4. Lot No. \_\_\_\_\_, Recorded Plat \_\_\_\_\_
5. Private Claims \_\_\_\_\_

	A	B	C	D	E	F	G	H	I	J	K	L	M
2	6	5	4	3	2	1							
3													
4	7	8	9	10	11	12							
5													
6	18	17	16	15	14	13							
7													
8	19	20	21	22	23	24							
9													
10	30	29	28	27	26	25							
11													
12	31	32	33	34	35	36							
13													

**Daniel E. Johnson**                      **May 26,**                      **95**

I, \_\_\_\_\_, in a field survey on \_\_\_\_\_, 19\_\_\_\_ do hereby certify that under requirements of P.A. 74, Michigan P.A. of 1970, the corner points mentioned in lines 1 and 2 above were in conformance with regulations and rules therefore as required in the current manual of survey instructions of the United States Department of the Interior, Bureau of Land Management or by a decree of a Court of Law and/or that the corner points mentioned in lines 3, 4 and 5 above were in conformance with the rules of the Michigan Board of Land Surveyors or by a Decree of a Court of Law; established, re-established, monumented, re-monumented, recovered, found as expressed below:

**NOTE: Not more than 1 corner, may be recorded on this certificate.**

A. Description of original monument and accessories and/or subsequent restoration:

**LIBER 007 PAGE 371**

**STATE PLAIN COORDINATES**


N. \_\_\_\_\_

E. \_\_\_\_\_

ELEVATION \_\_\_\_\_

B. Description of corner evidence found and/or method applied in restoring or reestablishing corner:

**LIBER 007 PAGE 371**

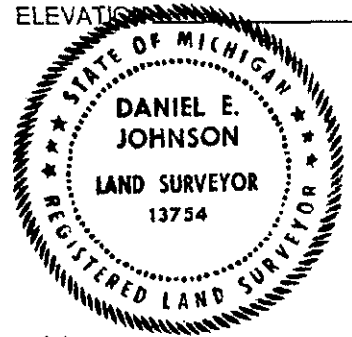

C. Description of monument for corner and accessories established to perpetuate locating the position of the corner:

Set 1/2"x18" Rerod with 2" dia. aluminum cap inscribed "St. Clair County Official Corner" with magnet

in Monument Box on centerline of existing Lapeer Rd. pavement and centerline of McLain Rd to north. Located on the true Township line.

- N 25°W 50.23' to set PK nail w/county remon tag in NE side of power pole
- N 22°E 70.08' to set PK nail w/county remon tag in W side of power pole
- S 24°W 52.06' to set PK nail w/county remon tag in W side of power pole
- S 40°E 90.41' to set PK nail w/county remon tag in NE side of twin 8" Box Elder
- WEST 2636.22' to S 1/4 corner of Section 32, T7N-R16E
- EAST 2636.56' to S 1/4 corner of Section 33, T7N-R16E

Signed by \_\_\_\_\_ *Daniel E. Johnson* Date May 26, 1995

**Daniel E. Johnson**

Surveyor's Michigan License No. #13754

**PA 345-1990  
PEER COMMITTEE**

**APPROVED** 6-10-95 *Dust*

APPROVED AS AN OFFICIAL GOVERNMENT CORNER BY ST. CLAIR COUNTY:

Signed By: \_\_\_\_\_ *Daniel E. Johnson* : \_\_\_\_\_ 7-31-95

St. Clair County Land Surveyor **Daniel E. Johnson** Date

**#13754**

Surveyor's Michigan License No. \_\_\_\_\_

LIBER **008** PAGE **84**