

ST. CLAIR COUNTY, MICHIGAN OFFICIAL GOVERNMENT CORNER



LAND CORNER RECORDATION CERTIFICATE
Filing Requirement of Act 74, Mich. P.A. 1970

	Located In:	Corner Code #	
1. Public Land Survey	Clyde Twp. T <u>7N.</u> R <u>16E.</u>	F-13	
	T _____ R _____	_____	
	T _____ R _____	_____	
	T _____ R _____	_____	
2. Property Controlling in Section	S _____ T _____ R _____	<i>Seg 2</i>	
	S _____ T _____ R _____	_____	
3. Miscellaneous Property in Sec.	S _____ T _____ R _____	_____	
	S _____ T _____ R _____	_____	

RECEIVED
1995 AUG -4 AM 10:13
REGISTER OF DEEDS
ST. CLAIR COUNTY
Register of Deeds Stamp & File Number

4. Lot No. _____, Recorded Plat _____
5. Private Claims _____

Daniel E. Johnson **May 25,** **95**
I, _____, in a field survey on _____, 19____, do hereby certify that under requirements of P.A. 74, Michigan P.A. of 1970, the corner points mentioned in lines 1 and 2 above were in conformance with regulations and rules theretofore as required in the current manual of survey instructions of the United States Department of the Interior, Bureau of Land Management or by a decree of a Court of Law and/or that the corner points mentioned in lines 3, 4 and 5 above were in conformance with the rules of the Michigan Board of Land Surveyors or by a Decree of a Court of Law; established, re-established, monumented, re-monumented, recovered, found as expressed below:

A	B	C	D	E	F	G	H	I	J	K	L	M
2	6	5	4	3	2	1						
3												
4	7	8	9	10	11	12						
5												
6	18	17	16	15	14	13						
7												
8	19	20	21	22	23	24						
9												
10	30	29	28	27	26	25						
11												
12	31	32	33	34	35	36						
13												

NOTE: Not more than 1 corner, may be recorded on this certificate.

A. Description of original monument and accessories and/or subsequent restoration:


LIBER 007 PAGE 370

STATE PLAIN COORDINATES

N. _____
E. _____

B. Description of corner evidence found and/or method applied in restoring or reestablishing corner:

LIBER 007 PAGE 370

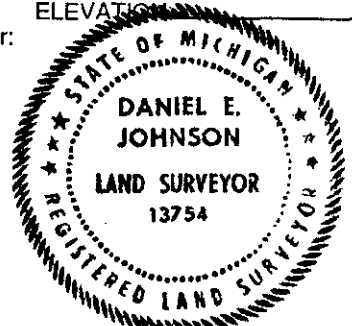

C. Description of monument for corner and accessories established to perpetuate locating the position of the corner:

Set 1/2"x18" Rerod with 2" dia. aluminum cap inscribed "St. Clair County Official Corner" with magnet (in Monument Box)
on centerline of existing Lapeer Rd. pvmt. Located on the true Township line.
NORTH 46.58' to set PK nail w/county remon tag in W side of power pole
N 30°W 59.88' to set PK nail w/county remon tag in E side 6" Elm Tree
S 60°W 120.48' to set PK nail w/county remon tag in NW side of power pole
S 70°E 128.45' to set PK nail w/county remon tag in NE side of power pole
WEST 2636.56' to SW corner Section 33, T7N-R16E
EAST 2632.78' to SE corner Section 33, T7N-R16E

Signed by *Daniel E. Johnson* Date May 25, 1995

Surveyor's Michigan License No. Daniel E. Johnson #13754

PA 345-1990
PEER COMMITTEE

APPROVED AS AN OFFICIAL GOVERNMENT CORNER BY ST. CLAIR COUNTY:

Signed By: *Daniel E. Johnson* : 7-31-95
St. Clair County Land Surveyor Daniel E. Johnson Date

Surveyor's Michigan License No. #13754 LIBER 008 PAGE 85

APPROVED 6-10-94 *Dand*