

ST. CLAIR COUNTY, MICHIGAN OFFICIAL GOVERNMENT CORNER



LAND CORNER RECORDATION CERTIFICATE Filing Requirement of Act 74, Mich. P.A. 1970

Located In: Port Huron Twp. Corner Code #

- | | | | |
|------------------------------------|----------------------------|-------|---------------|
| 1. Public Land Survey | T <u>7N.</u> R <u>17E.</u> | C-13 | |
| | T _____ R _____ | _____ | _____ |
| | T _____ R _____ | _____ | _____ |
| | T _____ R _____ | _____ | _____ |
| 2. Property Controlling in Section | S _____ T _____ R _____ | | <u>Seg. 2</u> |
| | S _____ T _____ R _____ | | |
| 3. Miscellaneous Property in Sec. | S _____ T _____ R _____ | | |
| | S _____ T _____ R _____ | | |
4. Lot No. _____, Recorded Plat _____
5. Private Claims _____

RECEIVED
 1995 AUG -4 AM 10:22
 REGISTER OF DEEDS
 ST. CLAIR COUNTY
 Register of Deeds Stamp & File Number

Daniel E. Johnson March 31 95

I, _____, in a field survey on _____, 19____, do hereby certify that under requirements of P.A. 74, Michigan P.A. of 1970, the corner points mentioned in lines 1 and 2 above were in conformance with regulations and rules therefore as required in the current manual of survey instructions of the United States Department of the Interior, Bureau of Land Management or by a decree of a Court of Law and/or that the corner points mentioned in lines 3, 4 and 5 above were in conformance with the rules of the Michigan Board of Land Surveyors or by a Decree of a Court of Law; established, re-established, monumented, re-monumented, recovered, found as expressed below:

NOTE: Not more than 1 corner, may be recorded on this certificate.

A. Description of original monument and accessories and/or subsequent restoration:

LIBER 007 PAGE 385

| | A | B | C | D | E | F | G | H | I | J | K | L | M |
|----|----|----|----|----|----|----|---|---|---|---|---|---|---|
| 2 | 6 | 5 | 4 | 3 | 2 | 1 | | | | | | | |
| 3 | | | | | | | | | | | | | |
| 4 | 7 | 8 | 9 | 10 | 11 | 12 | | | | | | | |
| 5 | | | | | | | | | | | | | |
| 6 | 18 | 17 | 16 | 15 | 14 | 13 | | | | | | | |
| 7 | | | | | | | | | | | | | |
| 8 | 19 | 20 | 21 | 22 | 23 | 24 | | | | | | | |
| 9 | | | | | | | | | | | | | |
| 10 | 30 | 29 | 28 | 27 | 26 | 25 | | | | | | | |
| 11 | | | | | | | | | | | | | |
| 12 | 31 | 32 | 33 | 34 | 35 | 36 | | | | | | | |
| 13 | | | | | | | | | | | | | |

STATE PLAIN COORDINATES


N. _____

E. _____

ELEVATION _____

B. Description of corner evidence found and/or method applied in restoring or reestablishing corner:

LIBER 007 PAGE 385

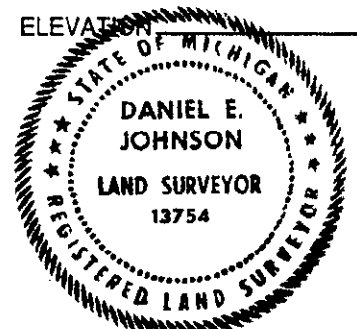

C. Description of monument for corner and accessories established to perpetuate locating the position of the corner:

Set 1/2" x 18" Rerod with 2" dia. aluminum cap inscribed "St. Clair County Official Corner" with magnet (in Monument Box)

1.2' south of centerline of exist. centerline of W. Water St. pavement. Located on the true Township line

- N 30° 30'E 56.26' to set PK nail w/county remon tag in NW side power pole
- N 60°W 133.85' to set PK nail w/county remon tag in NE side power pole
- S 60°W 83.92' to set PK nail w/county remon tag in SE side power pole
- S 29°W 59.69' to set PK nail w/county remon tag in N side Spruce tree
- S 85°E 153.63' to set PK nail w/county remon tag in NE side power pole
- WEST 2647.23' to S 1/4 corner of Section 31, T7N-R17E
- EAST 2637.01' to S 1/4 corner of Section 32, T7N-R17E

Signed by _____ Date March 31, 1995

Surveyor's Michigan License No. Daniel E. Johnson 13754

PA 345-1990
PEER COMMITTEE

APPROVED 6-10-94
Dan S

APPROVED AS AN OFFICIAL GOVERNMENT CORNER BY ST. CLAIR COUNTY:

Signed By: Daniel E. Johnson : 7-31-95

St. Clair County Land Surveyor Daniel E. Johnson
13754

Date

Surveyor's Michigan License No. _____

LIBER 008 PAGE 161