

ST. CLAIR COUNTY, MICHIGAN OFFICIAL GOVERNMENT CORNER



LAND CORNER RECORDATION CERTIFICATE Filing Requirement of Act 74, Mich. P.A. 1970

RECEIVED
 REGISTER OF DEEDS
 ST. CLAIR COUNTY
 1995 AUG -4 AM 10: 22

Located In: Port Huron Twp. Corner Code # E-13

- | | | |
|------------------------------------|------------------------------|--------------|
| 1. Public Land Survey | T <u>7</u> N. R <u>17</u> E. | <u>E-13</u> |
| | T _____ R _____ | _____ |
| | T _____ R _____ | _____ |
| | T _____ R _____ | _____ |
| 2. Property Controlling in Section | S _____ T _____ R _____ | <u>Sec 2</u> |
| | S _____ T _____ R _____ | _____ |
| 3. Miscellaneous Property in Sec. | S _____ T _____ R _____ | _____ |
| | S _____ T _____ R _____ | _____ |

Register of Deeds Stamp & File Number

4. Lot No. _____, Recorded Plat _____
 5. Private Claims _____

	A	B	C	D	E	F	G	H	I	J	K	L	M
2	6		5		4		3		2		1		
3													
4	7		8		9		10		11		12		
5													
6	18		17		16		15		14		13		
7													
8	19		20		21		22		23		24		
9													
10	30		29		28		27		26		25		
11													
12	31		32		33		34		35		36		
13													

Daniel E. Johnson March 31 95
 I, _____, in a field survey on _____, 19____, do hereby certify that under requirements of P.A. 74, Michigan P.A. of 1970, the corner points mentioned in lines 1 and 2 above were in conformance with regulations and rules therefore as required in the current manual of survey instructions of the United States Department of the Interior, Bureau of Land Management or by a decree of a Court of Law and/or that the corner points mentioned in lines 3, 4 and 5 above were in conformance with the rules of the Michigan Board of Land Surveyors or by a Decree of a Court of Law: established, re-established, monumented, re-monumented, recovered, found as expressed below:

NOTE: Not more than 1 corner, may be recorded on this certificate.

A. Description of original monument and accessories and/or subsequent restoration:

LIBER 007 PAGE 383


STATE PLAIN COORDINATES

N. _____
 E. _____

ELEVATION _____

B. Description of corner evidence found and/or method applied in restoring or reestablishing corner:

LIBER 007 PAGE 383

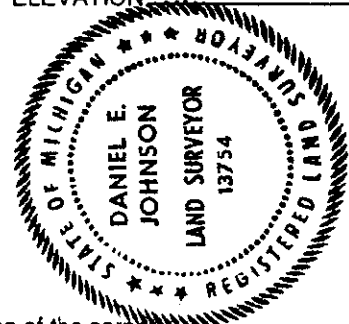

C. Description of monument for corner and accessories established to perpetuate locating the position of the corner:
 Set 1/2" x 18" Rerod with 2" dia. aluminum cap inscribed "St. Clair County Official Corner" with magnet (in Monument Box)
 on existing centerline of W Water St Pavement.

Located on the true Township line
 S70°W0.75' to PK nail
 EAST 21.54' to corner D-1, S. 1/4 corner Section 5, T6N-R17E
 N 16°W 29.22' to set PK nail w/county remon tag in E side power pole
 N 09°E 62.25' to set PK nail w/county remon tag in W side of power pole
 S 15°W 69.51' to set PK nail w/county remon tag in W side of small tree
 WEST 2619.19' to S 1/4 corner of Section 32, T7N-R17E
 EAST 2666.43' to S 1/4 corner of Section 33, T7N-R17E

Signed by _____ Date March 31, 1995

Surveyor's Michigan License No. 13754

PA 345-1990
 PEER COMMITTEE

APPROVED AS AN OFFICIAL GOVERNMENT CORNER BY ST. CLAIR COUNTY:

Signed By: Daniel E. Johnson : 7-31-95
 Date

St. Clair County Land Surveyor Daniel E. Johnson
13754

Surveyor's Michigan License No. _____

LIBER 008 PAGE 163