

ST. CLAIR COUNTY, MICHIGAN OFFICIAL GOVERNMENT CORNER



LAND CORNER RECORDATION CERTIFICATE Filing Requirement of Act 74, Mich. P.A. 1970

RECEIVED
 REGISTER OF DEEDS
 ST. CLAIR COUNTY
 1995 AUG -4 AM 10:23

Located In: _____ Corner Code # _____

Port Huron Twp.

1. Public Land Survey	T	7N.	R	17E.	F-13	
	T		R			
	T		R			
	T		R			
	T		R			
2. Property Controlling in Section	S		T		R	Leg 2
	S		T		R	
3. Miscellaneous Property in Sec.	S		T		R	
	S		T		R	

Register of Deeds Stamp & File Number

4. Lot No. _____, Recorded Plat _____
 5. Private Claims _____

	A	B	C	D	E	F	G	H	I	J	K	L	M
2	6	5	4	3	2	1							
3													
4	7	8	9	10	11	12							
5													
6	18	17	16	15	14	13							
7													
8	19	20	21	22	23	24							
9													
10	30	29	28	27	26	25							
11													
12	31	32	33	34	35	36							
13													

Daniel E. Johnson **March 31** **95**
 I, _____, in a field survey on _____, 19____, do hereby certify that under requirements of P.A. 74, Michigan P.A. of 1970, the corner points mentioned in lines 1 and 2 above were in conformance with regulations and rules therefore as required in the current manual of survey instructions of the United States Department of the Interior, Bureau of Land Management or by a decree of a Court of Law and/or that the corner points mentioned in lines 3, 4 and 5 above were in conformance with the rules of the Michigan Board of Land Surveyors or by a Decree of a Court of Law; established, re-established, monumented, re-monumented, recovered, found as expressed below:

NOTE: Not more than 1 corner, may be recorded on this certificate.

A. Description of original monument and accessories and/or subsequent restoration:

LIBER 007 PAGE 382

STATE PLAIN COORDINATES


N. _____

E. _____

ELEVATION _____

B. Description of corner evidence found and/or method applied in restoring or reestablishing corner:

LIBER 007 PAGE 382

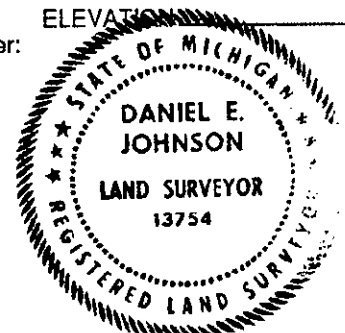

C. Description of monument for corner and accessories established to perpetuate locating the position of the corner:

Set 1/2" x 18" Rerod with 2" dia. aluminum cap inscribed "St. Clair County Official Corner" with magnet (in Monument Box)

on existing centerline of West Water Street Pavement

Located on the true Township line

N 45°W 53.80' to set PK nail w/county remon tag in SW side 24" Maple Tree

S 70°W 131.90' to set PK nail w/county remon tag in N side 20" Maple Tree

N 10°E 27.35' to set PK nail w/county remon tag in SSE side power pole

S 60°E 83.42' to set PK nail w/county remon tag in NE side 30" Box Elder Tree

WEST 2666.43' to SW corner Section 33, T7N-R17E

EAST 2206.58' to reference point for SE corner Section 33, T7N-R17E

EAST 1481.59' to iron in monument box @ centerline of Water St & W Water St

Signed by _____ Date March 31, 19

Surveyor's Michigan License No. Daniel E. Johnson 13754

PA 345-1990
PEER COMMITTEE

APPROVED AS AN OFFICIAL GOVERNMENT CORNER BY ST. CLAIR COUNTY:

Signed By: _____

St. Clair County Land Surveyor **Daniel E. Johnson**
13754

Date

Surveyor's Michigan License No. _____

7-31-95

APPROVED 6-10-94
Daniel E. Johnson

LIBER 008 PAGE 164