

**LAND CORNER RECORDATION CERTIFICATE**  
Filing Requirement of Act 74, Mich. P.A. 1970

LIBER **5** PAGE **15**

For corners in

ST. JOSEPH Located In: Corner Code #  
(County)  
LEONIDAS TWP.  
1. Public Land Survey T 5S R 9W B-11  
T \_\_\_\_\_ R \_\_\_\_\_  
T \_\_\_\_\_ R \_\_\_\_\_  
T \_\_\_\_\_ R \_\_\_\_\_  
2. Property Controlling S \_\_\_\_\_ T \_\_\_\_\_ R \_\_\_\_\_  
in Section S \_\_\_\_\_ T \_\_\_\_\_ R \_\_\_\_\_  
3. Miscellaneous S \_\_\_\_\_ T \_\_\_\_\_ R \_\_\_\_\_  
Property in Sec. S \_\_\_\_\_ T \_\_\_\_\_ R \_\_\_\_\_

STATE OF MICHIGAN  
ST. JOSEPH COUNTY  
FILED

17 SEP 97 3:24 P.M.

CYNTHIA JARRATT  
REGISTER OF DEEDS

Register of Deeds Stamp & File Number

4. Lot No. \_\_\_\_\_, Recorded Plat \_\_\_\_\_  
5. Private Claims \_\_\_\_\_

I, DAVID W. MOSTROM, in a field survey on AUG. 9, 1997 do hereby state that under requirements of P.A. 74, Michigan P.A. of 1970, the corner points mentioned in lines 1 and 2 above were in conformance with regulations and rules therefore as required in the current manual of survey Instructions of the United States Department of the Interior, Bureau of Land Management or by a decree of a Court of Law and /or that the corner points mentioned in lines 3, 4 and 5 above were in conformance with the rules of the Michigan Board of Land Surveyors or by a Decree of a Court of Law; established, re-established, monumented, recovered, found as expressed below:

NOTE: Not more than 2 corners, all in the same town and range, may be recorded on this certificate.

	A	B	C	D	E	F	G	H	I	J	K	L	M
1													
2	6	5	4	3	2	1							
3													
4	7	8	9	10	11	12							
5													
6	18	17	16	15	14	13							
7													
8	19	20	21	22	23	24							
9													
10	30	29	28	27	26	25							
11	●												
12	31	32	33	34	35	36							
13													

A. Description of original monument and accessories and/or subsequent restoration:

(B-11) ¼ CORNER COMMON TO SECTIONS 30 & 31, T5S R9W

*1886 SURVEY IN BK A, PG 533 CORNER NOT LABELED DIST. TO SW COR. SEC. 30 = 2589.18'	*1960'S ROAD COMMISSION LARGE POINTED STONE W/IRON 11" OAK = N70°W 70.00' 40" OAK = N15°W 32.27' 7" OAK = S25°E 29.36'	*1968 LARKIN WINTHER SURVEY CORNER NOT LABELED OR WITNESSED
--	--	--


B. Description of corner evidence found and/or method applied in restoring or reestablishing corner:

(B-11)  
FOUND 5" X 8" X 24" LONG CUT POINTED STONE IN CENTER OF SIMPSON ROAD (GRAVEL)  
.16" OAK STUMP = N70°W 70.00'  
46" OAK = N15°W 32.27'  
14" OAK = S12°E 29.36'  
DIST. TO SW COR. SEC. 30 = 2588.57'  
CORNER FALLS IN PROJ. OF FENCELINE TO NORTH

RATIFIED BY PEER GROUP  
IN ACCORDANCE WITH P.A. 345  
ON AUGUST 11, 1997  
W. CO. REPRESENTATIVE

C. Description of monument for corner and accessories established to perpetuate locating the position of the corner:

(B-11) ¼ CORNER COMMON TO SECTIONS 30 & 31, T5S R9W  
REMOVED STONE AND SET 5/8" X 24" IRON BAR W/STD. CAP IN MON. BOX  
N & W IN S. SIDE OF 7" W. OAK = N64°W 70.18'  
N & W IN E. SIDE OF 14" W. OAK = S12°E 29.36'  
N & W IN W. SIDE OF ANCHOR POST = SOUTH 31.13'  
N & W IN E. SIDE OF ANCHOR POST = S39°W 40.15'

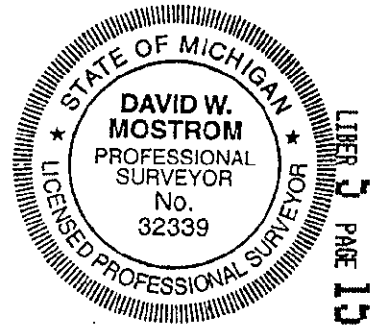

Signed by J. Mostrom DAVID W. MOSTROM  
Surveyor's Michigan License No. 32339

Date AUGUST 18, 1997