

**SURVEY &
REMONUMENTATION**

JAN 17 1996

LAND CORNER RECORDATION CERTIFICATE

Filing Requirement of Act 74, Mich. P.A. 1970

LIBER 4 PAGE 168

COMMISSION

For corners in
ST. JOSEPH
(County)
LEONIDAS TWP.

Located In:

Corner Code #


STATE OF MICHIGAN
ST. JOSEPH COUNTY
FILED

31 AUG 95 10:51 A.M.

CYNTHIA JARRATT
REGISTER OF DEEDS

Register of Deeds Stamp & File Number

- | | | | | | |
|--------------------------------------|---|-----------|---|-----------|------------|
| 1. Public Land Survey | T | <u>5S</u> | R | <u>9W</u> | <u>I-5</u> |
| | T | _____ | R | _____ | _____ |
| | T | _____ | R | _____ | _____ |
| | T | _____ | R | _____ | _____ |
| 2. Property Controlling in Section | S | _____ | T | _____ | R |
| | S | _____ | T | _____ | R |
| 3. Miscellaneous Property in Section | S | _____ | T | _____ | R |
| | S | _____ | T | _____ | R |
4. Lot No. _____, Recorded Plat _____
5. Private Claims _____

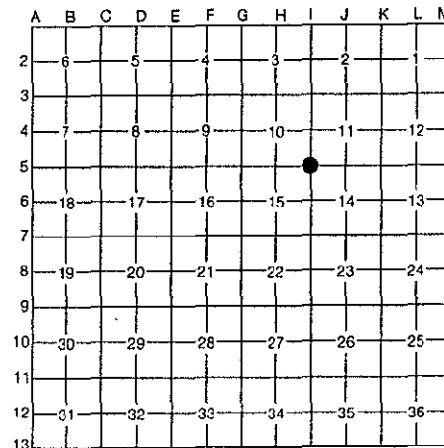

I, DAVID W. MOSTROM, in a field survey on NOVEMBER 21, 19 94, do hereby certify that under requirements of P.A. 74, Michigan P.A. of 1970, the corner points mentioned in lines 1 and 2 above were in conformance with regulations and rules therefore as required in the current manual of survey instructions of the United States Department of the Interior, Bureau of Land Management or by a decree of a Court of Law and/or that the corner points mentioned in lines 3, 4 and 5 above were in conformance with the rules of the Michigan Board of Professional Surveyors or by a Decree of a Court of Law; established, re-established, monumented, re-monumented, recovered, found as expressed below:

NOTE: Not more than 4 corners, all in the same town and range, may be recorded on this certificate.

A. Description of original monument and accessories and/or subsequent restoration:

<u>(I-5) NE CORNER SEC. 15 T5S, R9W</u>	<u>1883 SURVEY IN BOOK A, PG. 446</u>	<u>SURVEY IN BOOK A, PG. 632</u>	<u>SURVEY IN BOOK B, PG. 384</u>
STONE SET BY FORMER SURVEYOR	+ STONE BY FORMER SURVEYOR	+ STONE BY FORMER SURVEYOR	
<u>1883 SURVEY IN BOOK A, PG. 448</u>	<u>10" BLK OAK = N84 1/2°W 256. L.</u>	<u>10" BLK. WALNUT = N84 1/2°W 256 L</u>	
STONE SET BY FORMER SURVEYOR	<u>3" MAPLE = S15 1/2°W 118 L.</u>	<u>3" MAPLE = S16 1/2°W 118 L.</u>	
		<u>1971 SURVEY BY SAYERS</u>	
ROAD COMMISSION RECORDS SHOW CORNER WAS DUG FOR BY HAND BUT NOTHING WAS FOUND		<u>FOUND PIPE IN BOX</u>	

B. Description of corner evidence found and/or method applied in restoring or reestablishing corner:


(I-5)

FOUND 3/4"X 36" LONG IRON PIPE IN MON. BOX
DUG 4' UNDER PAVEMENT BUT FOUND NOTHING
CORNER APPEARS TO HAVE BEEN SET BY ROAD
COMMISSION USING NEARBY CORNERS

RATIFIED BY PEER GROUP
IN ACCORDANCE WITH P.A. 345
ON AUG 21, 1995
Wagon CO. REPRESENTATIVE

C. Description of monument for corner and accessories established to perpetuate locating the position of the corner:

(I-5) NE CORNER SEC. 15 T5S, R9W
SET 5/8"X24" IRON BAR W/STD. CAP IN PLACE OF 1/2" PIPE
N & W IN 10" MAPLE = S20°E 90.73'
N & W IN 14" MAPLE = S62°E 33.67'
N & W IN 36" MAPLE = N64°E 35.64'
N & W IN NE SIDE OF P. POLE = N55°W 57.70'
CL ROAD PROJ. TO WEST = SOUTH 2.3'
CL CORRELL RD. = EAST 0.3'

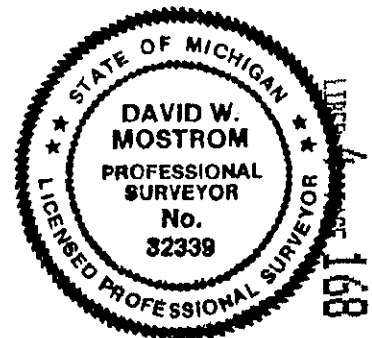

Signed by J. W. Mostrom

Date AUGUST 29, 1995

Surveyor's Michigan License No. 32339

FORM APPROVED BY MICHIGAN STATE BOARD OF PROFESSIONAL SURVEYORS, JAN. 28, 1971
REVISED MAY 14, 1975
REVISED JAN., 1983

REMONUMENTATION