

SURVEY & REMONUMENTATION COMMISSION
 APR 10 1995

LAND CORNER RECORDATION CERTIFICATE LIBER 4 PAGE 68
 Filing Requirement of Act 74, Mich. P.A. 1970

For corners in ST. JOSEPH (County) Located In: _____ Corner Code ## _____

LEONIDAS TWP.

1. Public Land Survey T 5S R 9W K=3
 T _____ R _____
 T _____ R _____
 T _____ R _____

2. Property Controlling in Section S _____ T _____ R _____
 S _____ T _____ R _____

3. Miscellaneous Property in Sec. S _____ T _____ R _____
 S _____ T _____ R _____

4. Lot No. _____, Recorded Plat _____

5. Private Claims _____

STATE OF MICHIGAN
 ST. JOSEPH COUNTY
 FILED
 6 DEC 94 4:30 P.M.
 CYNTHIA JARRATT
 REGISTER OF DEEDS
 Register of Deeds Stamp & File Number

I, DAVID W. MOSTROM, in a field survey on NOVEMBER 11, 1994, do hereby certify that under requirements of P.A. 74, Michigan P.A. of 1970, the corner points mentioned in lines 1 and 2 above were in conformance with regulations and rules therefore as required in the current manual of survey instructions of the United States Department of the Interior, Bureau of Land Management or by a decree of a Court of Law and/or that the corner points mentioned in lines 3, 4 and 5 above were in conformance with the rules of the Michigan Board of Land Surveyors or by a Decree of a Court of Law; established, re-established, monumented, re-monumented, recovered, found as expressed below:

NOTE: Not more than 4 corners, all in the same town and range, may be recorded on this certificate.

A	B	C	D	E	F	G	H	I	J	K	L
2	6	5	4	3	2	1					
3											
4	7	8	9	10	11	12					
5											
6	13	17	16	15	14	13					
7											
8	19	20	21	22	23	24					
9											
10	30	29	28	27	26	25					
11											
12	31	32	33	34	35	36					
13											

A. Description of original monument and accessories and/or subsequent restoration:

(K-3) CORNER COMMON TO SECTION 1,2,11,12

GLO

20" BEECH = N22°E 0.03 CH.
 16" BEECH = S79°W 0.08 CH.

1883 - BOOK A, PG. 448

STONE SET BY FORMER SURVEYOR
 NO WITNESSES

1984 SAYERS SURVEY #12318

SET 1/2" IRON OVER R.R. SPIKE 20" DEEP
 20" CHERRY = SOUTH 61.10'
 POST = S30°W 40.31'
 +IN TOP OF R.R. POST = NORTH 30.19'

LCRC IN BK. 3, PG. 196

CARR SURVEY #91-2687

FOUND 1/2" CAPPED IRON #7874 IN CL OF ROAD EAST & WEST-IN LINE W/FENCE TO SOUTH. R.R. RAIL FENCE COR. POST = SOUTH 32.5'
 R.R. RAIL FENCE COR. POST = NORTH 30.0'
 30" CHERRY = SOUTH 60.95'
 E'LY END OF 12" CULVERT = S45°E 35.4'

B. Description of corner evidence found and/or method applied in restoring or reestablishing corner:

(K-3)


FOUND 1/2" IRON BAR CAPPED #7874
 DUG 2' X 2' X 3' DEEP HOLE BUT FOUND NO EVIDENCE OF STONE
 IRON FALLS WITHIN 0.2' OF DBL'D OVER DIST OF CORNERS
 1/4 MILE & 1/2 MILE WEST
 IN CL OF ROAD EAST & WEST
 IN LINE W/FENCE TO SOUTH
 R.R. FENCE COR. POST = SOUTH 32.5'
 R.R. FENCE COR. POST = NORTH 30.0'
 30" CHERRY = SOUTH 60.95'
 E'LY END OF 12" CULVERT = S45°E 35.4'

RATIFIED BY PEER GROUP
 IN ACCORDANCE WITH P.A. 345
 ON NOV. 14, 1994
Warr CO. REPRESENTATIVE

C. Description of monument for corner and accessories established to perpetuate locating the position of the corner:

(K-3) CORNER COMMON TO SECTIONS 1,2,11,12

SET 5/8" X 24" IRON W/STD. CAP IN PLACE OF 1/2" IRON BAR FOUND IN MON. BOX
 PK NAIL & TAG 2' HIGH ON E. SIDE OF 7" HICKORY = SOUTH 31.30'
 PK NAIL & TAG 2' HIGH ON W. SIDE OF P. POLE = NORTH 95.37'
 PK NAIL & TAG 2' HIGH ON E. SIDE OF 8" GATE POST = S40°W 40.57'
 PK NAIL & TAG 2' HIGH ON NW. SIDE OF 6" WALNUT = S60°W 57.83'
 CL OF EXISTING ROADWAY = NORTH 0.50'
 IN LINE WITH FENCE TO SOUTH

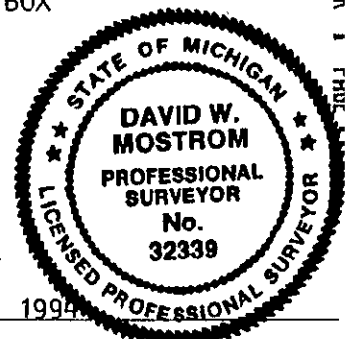

Signed by [Signature] Date NOV. 21, 1994

Surveyor's Michigan License No. 32339

REMONUMENTATION