

LAND CORNER RECORDATION CERTIFICATE
 Filing Requirement of Act 74, Mich. P.A. 1970

For corners in Mendon Twp.

LIBER 6 PAGE 3

STATE OF MICHIGAN
 ST. JOSEPH COUNTY
 FILED

7 JAN 2000 9:45:49 AM

CYNTHIA L. JARRATT
 REGISTER OF DEEDS


Register of Deeds Stamp & File Number

<u>St. Joseph</u> (County)	Located In:	Corner Code #
1. Public Land Survey	T ___ R ___	_____
	T ___ R ___	_____
	T ___ R ___	_____
	T ___ R ___	_____
2. Property Controlling in Section	S <u>15</u> T <u>5S</u> R <u>10W</u>	<u>H-6</u>
	S ___ T ___ R ___	_____
3. Miscellaneous Property in Sec.	S ___ T ___ R ___	_____
	S ___ T ___ R ___	_____

4. Lot No. _____, Recorded Plat _____
 5. Private Claims _____

I, David W. Mostrom, in a field survey on 9/10, 1999 do hereby state that under requirements of P.A. 74, Michigan P.A. of 1970, the corner points mentioned in lines 1 and 2 above were in conformance with regulations and rules therefore as required in the current manual of survey instructions of the United States Department of the Interior, Bureau of Land Management or by a decree of a Court of Law and/or that the corner points mentioned in lines 3, 4 and 5 above were in conformance with the rules of the Michigan Board of Land Surveyors or by a Decree of a Court of Law; established, re-established, monumented, recovered, found as expressed below:

NOTE: Not more than 2 corners, all in the same town and range, may be recorded on this certificate.

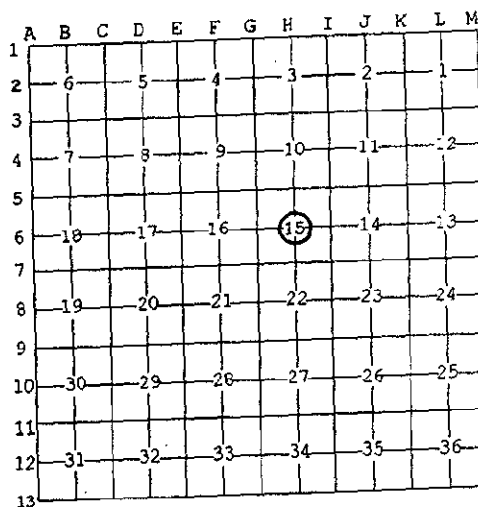

A. Description of original monument and accessories and/or subsequent restoration:

(H-6) Intersection of West line of Nottawaseepe Reserve Line and East-West 1/4 Line of Section 15 T5S, R10W

- * GLO - Corner not set
- * 1876 Survey in Bk A, Pg 238 Stone set midway bet. 1/4 posts
- 10" Y. Oak = S82 1/4°E 42.24'
- 3" Y. Oak = N40 1/2°W 38.50'
- * 1896 Survey in Bk.A, Pg 737 Stone established from two witnesses noted by Andrews in 1876
- 20" Y. Oak = N40 1/4°W 38.50'
- + 'd. stone = S74 1/2°E 14.96'
- * 1961 Road Commission 1/2" pipe driven through delayed wood stake laying horizontal
- 20" Oak = S42°E 53.35'
- 1 Beam Post = West 26.75'
- 46" Oak = N41°W 38.4'

B. Description of corner evidence found and/or method applied in restoring or reestablishing corner:

Found 3/4" pipe 0.5' deep in gravel rdwy.
 36" Oak = S42°E 53.35'
 1 Beam Post = West 26.75' (face)
 Cor. falls in line w/fences East & West
 C Buchner Road = East 1'±
 Cor. falls in 7'± cut area in rdwy.
 Set 5/8" x 24" iron bar w/std. cap in Mon. box in place of pipe

RATIFIED BY PEER GROUP
 IN ACCORDANCE WITH P.A. 345
 ON SEPT. 13, 1999
Wm. Co. REPRESENTATIVE

C. Description of monument for corner and accessories established to perpetuate locating the position of the corner:

5/8" x 24" iron bar w/std. cap in Mon. box
 N & W 1.0' high on S. side of 42" Oak = S35°E 53.64'
 NE edge of RR Rail 1.0' high = N83°W 26.84'
 5/8" iron bar = N40°E 27.69'
 5/8" iron bar = S23°W 49.89'



Signed by J. W. Mostrom David W. Mostrom
 Surveyor's Michigan License No. 32339

Date September 21, 1999

REMONUMENTATION

LIBER 6 PAGE 3