

**SURVEY & REMONUMENTATION**

JAN 22 1999

SECTION

**LAND CORNER RECORDATION CERTIFICATE**  
Filing Requirement of Act 74, Mich. P.A. 1970

LIBER 5 PAGE 129  
STATE OF MICHIGAN  
ST. JOSEPH COUNTY  
FILED

For corners in

St. Joseph (County)	Located in:	Corner Code #
Mendon Twp.	T 5S R 10W	H-7
1. Public Land Survey	T R	
	T R	
	T R	
2. Property Controlling in Section	S T R	
	S T R	
3. Miscellaneous Property in Sec.	S T R	
	S T R	

28 DEC 1998 1:31:06 PM

CYNTHIA L. JARRATT  
REGISTER OF DEEDS

Register of Deeds Stamp & File Number

4. Lot No. \_\_\_\_\_, Recorded Plat \_\_\_\_\_  
5. Private Claims \_\_\_\_\_

I, David W. Mostrom, in a field survey on 9/5, 1998 do hereby state that under requirements of P.A. 74, Michigan P.A. of 1970, the corner points mentioned in lines 1 and 2 above were in conformance with regulations and rules therefore as required in the current manual of survey instructions of the United States Department of the Interior, Bureau of Land Management or by a decree of a Court of Law and/or that the corner points mentioned in lines 3, 4 and 5 above were in conformance with the rules of the Michigan Board of Land Surveyors or by a Decree of a Court of Law; established, re-established, monumented, recovered, found as expressed below:

A	B	C	D	E	F	G	H	I	J	K	L	M
1												
2	6	5	4	3	2	1						
3												
4	7	8	9	10	11	12						
5												
6	18	17	16	15	14	13						
7												
8	19	20	21	22	23	24						
9												
10	30	29	28	27	26	25						
11												
12	31	32	33	34	35	36						
13												

NOTE: Not more than 2 corners, all in the same town and range, may be recorded on this certificate.

A. Description of original monument and accessories and/or subsequent restoration:

(H-7) 3 MILE POST ON THE WEST LINE OF THE NOTTAWASEEPE INDIAN RESERVE AND THE CLOSING CORNER FOR LINE BETWEEN SECTIONS 15 & 22 TO THE WEST

- \*GLO Post
  - 6" W. Ash=S44°W 7.92'
  - 8" W. Ash=N66°W 17.16'
- \*1876 Survey in Bk A, P 238
  - Stone set by Hutchinson from original bearings
  - 6" Maple=N49½°E 47.08'
- \*1898 Survey in Bk A, P789
  - Stone set by Hutchinson
  - 24" Elm=S18°W 62.7'
  - 8" Maple=S43½°W 30.36'
- \*1902 Survey in Bk 1, P 48
  - Stone set by Hutchinson
- \*1960's Road Commission
  - Pointed stone surrounded by brick, pottery, glass
  - 34" Maple=N50°E 47.55'
  - Anchor post=N64°W 27.2'
  - 16" Maple=S42°W 60.6'
  - 19" Maple=S25°E 86.67'
  - 22" Walnut=S70°E 57.6'


B. Description of corner evidence found and/or method applied in restoring or reestablishing corner:

Found ½" x 12" iron bar over pointed stone in mon. box  
Corner falls in CL of Buchner Road & 4'± North of Taylor Road to East  
40" Maple=N53°E 47.55'±  
34" Walnut=S67°E 57.6'±  
Set 5/8" x 24" Iron bar w/std. cap over stone in mon. box

RATIFIED BY PEER GROUP  
IN ACCORDANCE WITH P.A. 345  
ON Sept. 14, 1998  
Wen CO. REPRESENTATIVE

C. Description of monument for corner and accessories established to perpetuate locating the position of the corner:

5/8" x 24" Iron bar w/std. cap over stone in mon. box  
N & W 1.5' high in SE side of 40" Maple=N53°E 47.73'  
N & W 1.0' high in S. side of 34" Walnut=S67°E 57.21'  
N & W 2.0' high in N. side of 36" Maple=S80°W 83.66'  
Iron bar in ditch=N42°W 37.11'

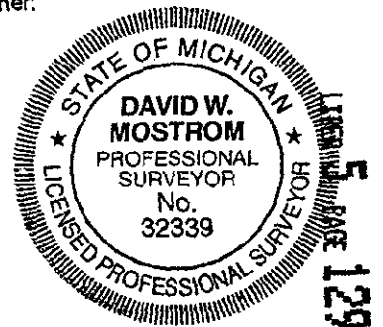

Signed by [Signature] David W. Mostrom  
Surveyor's Michigan License No. 32339

Date September 29, 1998

REMONUMENTATION