

**SURVEY & REMONUMENTATION COMMISSION**  
 APR 10 1995

**LAND CORNER RECORDATION CERTIFICATE**  
**Filing Requirement of Act 74, Mich. P.A. 1970**

For corners in ST. JOSEPH (County) Located In: \_\_\_\_\_ Corner Code D-3

PARK TOWNSHIP

1. Public Land Survey	T <u>5S</u> R <u>11W</u>	<u>D-3</u>
	T _____ R _____	_____
	T _____ R _____	_____
	T _____ R _____	_____
2. Property Controlling in Section	S _____ T _____ R _____	_____
	S _____ T _____ R _____	_____
3. Miscellaneous Property in Sec.	S _____ T _____ R _____	_____
	S _____ T _____ R _____	_____


STATE OF MICHIGAN  
 ST. JOSEPH COUNTY  
 FILED  
 6 DEC 94 4:30 P.M.  
 CYNTHIA JARRATT  
 REGISTER OF DEEDS

Register of Deeds Stamp & File Number

4. Lot No. \_\_\_\_\_, Recorded Plat \_\_\_\_\_
5. Private Claims \_\_\_\_\_

I, DAVID W. MOSTROM, in a field survey on OCTOBER 7, 1994, do hereby certify that under requirements of P.A. 74, Michigan P.A. of 1970, the corner points mentioned in lines 1 and 2 above were in conformance with regulations and rules therefore as required in the current manual of survey instructions of the United States Department of the Interior, Bureau of Land Management or by a decree of a Court of Law and/or that the corner points mentioned in lines 3, 4 and 5 above were in conformance with the rules of the Michigan Board of Land Surveyors or by a Decree of a Court of Law; established, re-established, monumented, re-monumented, recovered, found as expressed below:

**NOTE: Not more than 4 corners, all in the same town and range, may be recorded on this certificate.**

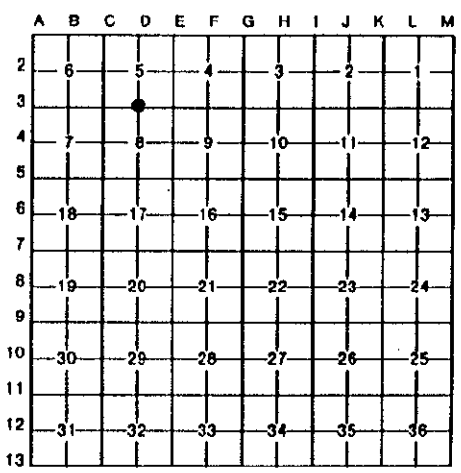

A. Description of original monument and accessories and/or subsequent restoration:

**(D-3) 1/4 CORNER COMMON TO SECTIONS 5 & 8**

**GLO**

**LCRC IN BOOK 3, PG. 20 & SAYERS SURVEY #9411**

5" W. OAK = S29½°E 37 LINKS  
 8" W. OAK = S78°W 1.22 CHAINS

FOUND 1/2" IRON IN N-S FENCE & FENCE TO EAST  
 20" DBL W. OAK = NORTH 12.45'  
 12" OAK = N85°E 7.2'  
 8" OAK = SOUTH 4.5'

**1892 - BOOK A, PG 666**

SET W.O. POST IN REMAINS OF ORIG. POST

W. OAK = S29½°E 37 LINKS

B. Description of corner evidence found and/or method applied in restoring or reestablishing corner:

**(D-3)**

FOUND 1/2" IRON IN N-S FENCE & FENCE TO EAST  
 20" DBL. W. OAK = NORTH 12.45'  
 12" OAK = N85°E 7.2'  
 8" OAK = SOUTH 4.5'

DIMENSIONS TO ADJACENT CORNERS ARE SHOWN ON A COPY OF SAYERS WORKSHEET INCLUDED IN RE-MON. FOLDER

RATIFIED BY PEER GROUP  
 IN ACCORDANCE WITH P.A. 345  
 ON Nov. 14, 1994  
Wm CO. REPRESENTATIVE

C. Description of monument for corner and accessories established to perpetuate locating the position of the corner:

**(D-3)**

SET 5/8" X 24" IRON BAR W/STD. CAP IN N-S FENCE & IN FENCE TO EAST  
 PK NAIL & TAG 2' HIGH ON W. SIDE OF 28" DBL. W. OAK = NORTH 12.45'  
 PK NAIL & TAG 2' HIGH ON N. SIDE OF 26" B. OAK = N85°E 7.20'  
 PK NAIL & TAG 1' HIGH ON E. SIDE OF 10" B. OAK = SOUTH 4.50'  
 PK NAIL & TAG 2' HIGH ON E. SIDE OF 4" DBL. HICKORY = N45°E 40.10'



Signed by [Signature]

Date NOVEMBER 17, 1994

Surveyor's Michigan License No. 32339

**REMONUMENTATION**

LIBER 4 PAGE 01