

FEB 23 2001

SECTION

LAND CORNER RECORDATION CERTIFICATE
Filing Requirement of Act 74, Mich. P.A. 1970

LIBER 6 PAGE 21

STATE OF MICHIGAN
ST. JOSEPH COUNTY
FILED

29 MAR 2000 10:13:32 AM

CYNTHIA L. JARRATT
REGISTER OF DEEDS

For corners in Park Township

St. Joseph County (County)	Located in:	Corner Code #
1. Public Land Survey	T 5S R 11W	E-7
	T R	
	T R	
	T R	
2. Property Controlling in Section	S T R	
	S T R	
3. Miscellaneous Property in Sec.	S T R	
	S T R	

Register of Deeds Stamp & File Number

4. Lot No. _____, Recorded Plat _____
5. Private Claims _____

I, David W. Mostrom, in a field survey on March 8, 2000 do state that under requirements of P.A. 74, Michigan P.A. of 1970, the corner points mentioned in lines 1 and 2 above were in conformance with regulations and rules therefore as required in the current manual of survey instructions of the United States Department of the Interior, Bureau of Land Management or by a decree of a Court of Law and/or that the corner points mentioned in lines 3, 4 and 5 above were in conformance with the rules of the Michigan Board of Land Surveyors or by a Decree of a Court of Law, established, re-established, monumented, recovered, found as expressed below:

NOTE: Not more than 2 corners, all in the same town and range, may be recorded on this certificate.

(E-7) CORNER COMMON TO SECTIONS 16, 17, 20, 21 PARK TOWNSHIP


A. Description of original monument and accessories and/or subsequent restoration:

GLO
6" W. OAK = N43°W 234.96'
6" OAK = S81°W 273.9'

1991 GOVE SURVEY
CORNER SHOWN BUT NOT
LABELED OR WITNESSED

1972 SAYERS SURVEYS
CORNER USED BUT NOT
LABELED OR WITNESSED

A	B	C	D	E	F	G	H	I	J	K	L	M
1												
2	6		5		4		3		2		1	
3												
4	7		8		9		10		11		12	
5												
6	18		17		16		15		14		13	
7												
8	19		20		21		22		23		24	
9												
10	30		29		28		27		26		25	
11												
12	31		32		33		34		35		36	
13												

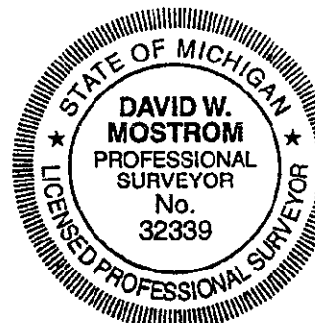

B. Description of corner evidence found and/or method applied in restoring or reestablishing corner:

FOUND 3/4" X 19" PIPE OVER POINTED STONE 22" DEEP IN MONUMENT BOX
CENTERLINE MARCELLUS ROAD = NORTH 1.0'
CORNER FALLS IN LINE WITH FENCE TO SOUTH
SET 5/8" X 16" IRON BAR WITH STD. CAP IN CONCRETE OVER STONE IN MONUMENT

C. Description of monument for corner and accessories established to perpetuate locating the position of the corner:

5/8" X 16" IRON BAR WITH STD. CAP IN MONUMENT BOX
N & W IN E. SIDE OF ANCHOR POST = SOUTH 25.38'
N & W IN NW SIDE OF 11" CHERRY = S48°W 40.65'
N & W IN E. SIDE OF 20" OAK = N15°W 40.75'
N & W IN W. SIDE OF 20" OAK = N03°W 31.25'
N & W IN S. SIDE OF 41" OAK = N70°E 83.10'

RATIFIED BY PEER GROUP
IN ACCORDANCE WITH P.A. 345
ON MAR. 13, 2000
Waco CO. REPRESENTATIVE

Signed by J. D. W. Mostrom David W. Mostrom Date March 23, 2000
Surveyor's Michigan License No. 32339

REMONUMENTATION

LIBER 6 PAGE 21