

**SURVEY &
REMONUMENTATION**

DEC 1 6 1996

COMMISSION

LAND CORNER RECORDATION CERTIFICATE
Filing Requirement of Act 74, Mich. P.A. 1970 **LIBER 4 PAGE 263**

For corners in St. Joseph Located In: _____ Corner Code # _____
(County)

1. Public Land Survey T 5S R 11W H-7
T _____ R _____
T _____ R _____
T _____ R _____

2. Property Controlling S _____ T _____ R _____
in Section S _____ T _____ R _____

3. Miscellaneous S _____ T _____ R _____
Property in Sec. S _____ T _____ R _____

4. Lot No. _____, Recorded Plat _____

5. Private Claims _____

STATE OF MICHIGAN
ST. JOSEPH COUNTY
FILED

23 OCT 96 12:55 P.M.

CYNTHIA JARRATT
REGISTER OF DEEDS

Register of Deeds Stamp & File Number

I, Donald C. Andrews, in a field survey on August 19, 1996, do hereby certify that under requirements of P.A. of 1970, the corner points mentioned in lines 1 and 2 above were in conformance with regulations and rules therefore as required in the current manual of survey instructions of the United States Department of the Interior, Bureau of Land Management or by a decree of a Court of Law and/or that the corner points mentioned in lines 3, 4 and 5 above were in conformance with the rules of the Michigan Board of Land Surveyors or a Decree of a Court of Law; established, re-established, monumented, re-monumented, recovered, found as expressed below:

NOTE: Not more than 4 corners, all in the same town and range, may be recorded on this certificate.

A. Description of original monument and accessories and/or subsequent restoration:

GLO Post Y. Oak 18" S27°E 0.29ch, Y. Oak 12" N85°W 0.74 ch.

Todd, Co. Surveyor Bk. A, P. 531 Stone

LCRC 3, P. 195 Found "+" Stone/Box : 12" Ash N. 30.63', SW Cor. Hse. N20°E 80.7', 6" Maple N40°E 53.25'

B. Description of corner evidence found and/or method applied in restoring or reestablishing corner:


Found record "+" stone in mon box. witnesses from LCRC checked OK

RATIFIED BY PEER GROUP
IN ACCORDANCE WITH P.A. 345
ON AUG 12, 1996
Wm CO. REPRESENTATIVE

C. Description of monument for corner and accessories established to perpetuate locating the position of the corner:

set Alum. capped 5/8" x 8" iron in concrete inside of existing mon box over "+" stone: 14" Locust North 30.47', 6" Maple N40°E 53.18', 8" Maple N70°E 131.75', SW Cor. Hse. N20°E 80.67'

Signed by Donald C. Andrews
Donald C. Andrews, P.S.
Surveyor's Michigan License No. 33967

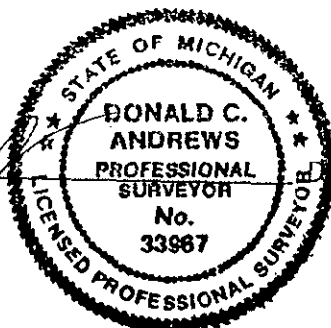

Date 8/27/96

FORM APPROVED BY MICHIGAN STATE BOARD OF LAND SURVEYORS, JAN. 28, 1971
REVISED MAY 14, 1975
REVISED JAN., 1983
ADAPTED FOR WORD-PROCESSING

LIBER 4 PAGE 263

REMONUMENTATION