

**SURVEY &  
REMONUMENTATION**

DEC 1 6 1996

COMMISSION

**LAND CORNER RECORDATION CERTIFICATE  
Filing Requirement of Act 74, Mich. P.A. 1970**

LIBER 4 PAGE 265  
INDEXED 774 PAGE 70

For corners in St. Joseph Located in: \_\_\_\_\_ Corner Code # \_\_\_\_\_  
(County)

- 1. Public Land Survey T 5S R 11W \_\_\_\_\_  
T \_\_\_\_\_ R \_\_\_\_\_  
T \_\_\_\_\_ R \_\_\_\_\_  
T \_\_\_\_\_ R \_\_\_\_\_
- 2. Property Controlling S \_\_\_\_\_ T \_\_\_\_\_ R \_\_\_\_\_  
in Section S \_\_\_\_\_ T \_\_\_\_\_ R \_\_\_\_\_
- 3. Miscellaneous S \_\_\_\_\_ T \_\_\_\_\_ R \_\_\_\_\_  
Property in Sec. S \_\_\_\_\_ T \_\_\_\_\_ R \_\_\_\_\_
- 4. Lot No. \_\_\_\_\_, Recorded Plat \_\_\_\_\_
- 5. Private Claims \_\_\_\_\_

STATE OF MICHIGAN  
ST. JOSEPH COUNTY  
FILED

23 OCT 96 12:56 P.M.

CYNTHIA JARRATT  
REGISTER OF DEEDS

**Register of Deeds Stamp & File Number**

I, Donald C. Andrews, in a field survey on August 19, 1996, do hereby certify that under requirements of P.A. of 1970, the corner points mentioned in lines 1 and 2 above were in conformance with regulations and rules therefore as required in the current manual of survey instructions of the United States Department of the Interior, Bureau of Land Management or by a decree of a Court of Law and/or that the corner points mentioned in lines 3, 4 and 5 above were in conformance with the rules of the Michigan Board of Land Surveyors or a Decree of a Court of Law; established, re-established, monumented, re-monumented, recovered, found as expressed below:

**NOTE: Not more than 4 corners, all in the same town and range, may be recorded on this certificate.**

**A. Description of original monument and accessories and/or subsequent restoration:**

GLO Post  
Todd Bk. A, P. 287 Stone (witnesses were stumps)  
Gardner Bk. A, P. 86 Stone set from bearings  
LCRC 3, P. 26 mon box & stone by Sayers: 72" stone NE 44.6', 30" twin Oak SW 56.3'  
corner is shown on Plat of Parkville  
Sayers corner index sheet shows pipe/box  
Mostrom records : 1981 found stone in box, 1988 found pipe in mon box

	A	B	C	D	E	F	G	H	I	J	K	L	M
2	6	5	4	3	2	1							
3													
4	7	8	9	10	11	12							
5													
6	18	17	16	15	14	13							
7													
8	19	20	21	22	23	24							
9													
10	30	29	28	27	26	25							
11													
12	31	32	33	34	35	36							
13													

**B. Description of corner evidence found and/or method applied in restoring or reestablishing corner:**


found record "+" pointed stone in mon box down 4"

RATIFIED BY PEER GROUP  
IN ACCORDANCE WITH P.A. 345  
ON AUG. 12, 1996  
XXXX CO. REPRESENTATIVE

**C. Description of monument for corner and accessories established to perpetuate locating the position of the corner:**

set Alum. capped 5/8"x4" iron in concrete in existing mon box over "+" pointed stone: 48" Oak S22°W 57.49', 29" Oak N18°W 110.96', face of 4' high x 7' long x 5' wide stone N45°E 43.96'

Signed by Donald C. Andrews  
Donald C. Andrews, P.S.  
Surveyor's Michigan License No. 33967

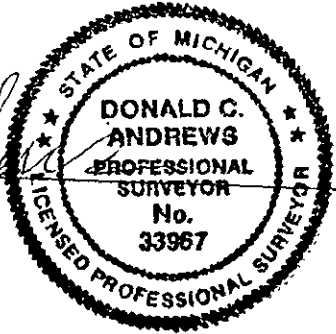

Date 8/27/96

FORM APPROVED BY MICHIGAN STATE BOARD OF LAND SURVEYORS, JAN. 28, 1971  
REVISED MAY 14, 1975  
REVISED JAN., 1983  
ADAPTED FOR WORD-PROCESSING

LIBER 4 PAGE 265

**REMONUMENTATION**