

DEC 1 6 1996

COMMISSION

LAND CORNER RECORDATION CERTIFICATE

Filing Requirement of Act 74, Mich. P.A. 1970, MER 4 PAGE 266

For corners in St. Joseph Located In: _____ Corner Code # _____
 (County)

1. Public Land Survey T 5S R 11W L-3 _____
 T _____ R _____
 T _____ R _____
 T _____ R _____

2. Property Controlling S _____ T _____ R _____
 in Section S _____ T _____ R _____

3. Miscellaneous S _____ T _____ R _____
 Property in Sec. S _____ T _____ R _____

4. Lot No. _____, Recorded Plat _____

5. Private Claims _____

STATE OF MICHIGAN
ST. JOSEPH COUNTY
FILED

13 NOV 96 12:59 P.M.

CYNTHIA JARRATT
REGISTER OF DEEDS

Register of Deeds Stamp & File Number

I, Donald C. Andrews, in a field survey on August 19, 1996, do hereby certify that under requirements of P.A. of 1970, the corner points mentioned in lines 1 and 2 above were in conformance with regulations and rules therefore as required in the current manual of survey instructions of the United States Department of the Interior, Bureau of Land Management or by a decree of a Court of Law and/or that the corner points mentioned in lines 3, 4 and 5 above were in conformance with the rules of the Michigan Board of Land Surveyors or a Decree of a Court of Law; established, re-established, monumented, re-monumented, recovered, found as expressed below:

	A	B	C	D	E	F	G	H	I	J	K	L	M
2	6	5	4	3	2	1							
3												6	
4	7	8	9	10	11	12							
5													
6	18	17	16	15	14	13							
7													
8	19	20	21	22	23	24							
9													
10	30	29	28	27	26	25							
11													
12	31	32	33	34	35	36							
13													

NOTE: Not more than 4 corners, all in the same town and range, may be recorded on this certificate.

A. Description of original monument and accessories and/or subsequent restoration:

GLO Post

1972 Sayers set corner midway between what he believed to be the location of K-3 and the approved corner M-3.

Corner shown on plat of Hampton Park as was set by Sayers. Plat was done by Sayers

survey shown in Bk. A, P. 275 shows that Center of Section 12 was set on line between the N1/4 corner (L-3) and the S1/4 corner of Sec. 12

B. Description of corner evidence found and/or method applied in restoring or reestablishing corner:


Established new location of the NW Corner of Sec. 12 (K-3) per the direction of the Peer Group and reestablished N1/4 Sec. 12 Corner (L-3) at the intersection of the North line of Section 12 and the N-S1/4 line of Section 12. This location is close to the mid point of a line defined by the NW corner and the NE corner of Section 12.

RATIFIED BY PEER GROUP
IN ACCORDANCE WITH P.A. 345
ON AUG. 12, 1996
Wren CO. REPRESENTATIVE

C. Description of monument for corner and accessories established to perpetuate locating the position of the corner:

set Alum Capped iron in mon box: ^{5/8" X 24"} 34" Maple N50°W 42.18', conc. mon S45°W 52.06', 36" Maple N75°E 95.28', and 5/8" iron in mon box East 13.87'

Signed by Donald C. Andrews
Donald C. Andrews, P.S.
Surveyor's Michigan License No. 33967

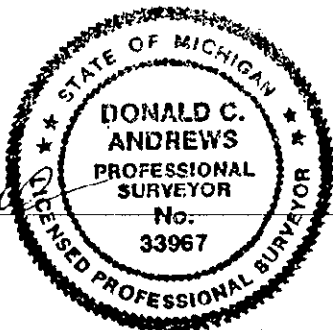

Date 8/27/96

LITER 4 PAGE 266