

STATE OF MICHIGAN
ST. JOSEPH COUNTY
FILED

LAND CORNER RECORDATION CERTIFICATE
Filing Requirement of Act 74, Mich. P.A. 1970

15 NOV 1999 10:35:47 AM

CYNTHIA L. JARRATT
REGISTER OF DEEDS

SECTION

For corners in

St. Joseph

(County)

Park Twp.

1. Public Land Survey

Located in:

Corner Code #

T.5S R.11W

L-5

T. R.

T. R.

T. R.

S. T. R.

S. T. R.

S. T. R.

S. T. R.

2. Property Controlling
in Section

3. Miscellaneous
Property in Sec.

Register of Deeds Stamp & File Number

4. Lot No. _____, Recorded Plat _____

5. Private Claims _____

I, Wayne A. Mostrom, in a field survey on Nov. 2, 19 99 do hereby state that under requirements of P.A. 74, Michigan P.A. of 1970, the corner points mentioned in lines 1 and 2 above were in conformance with regulations and rules therefore as required in the current manual of survey instructions of the United States Department of the Interior, Bureau of Land Management or by a decree of a Court of Law and /or that the corner points mentioned in lines 3, 4 and 5 above were in conformance with the rules of the Michigan Board of Land Surveyors or by a Decree of a Court of Law; established, re-established, monumented, recovered, found as expressed below:

NOTE: Not more than 2 corners, all in the same town and range, may be recorded on this certificate.

1	A	B	C	D	E	F	G	H	I	J	K	L	M
2		6		5		4		3		2		1	
3													
4		7		8		9		10		11		12	
5													
6		18		17		16		15		14		13	
7													
8		19		20		21		22		23		24	
9													
10		30		29		28		27		26		25	
11													
12		31		32		33		34		35		36	
13													

A. Description of original monument and accessories and/or subsequent restoration:

1878 Survey in A/274

Stone set midway bet cor's
8" Cherry-S11 3/4°W 59 1/2'ls
(34.71')

Road Commission 1964

Large Pointed Stone
under box
15" Hick=N48°W 31.35'
SE Cor Hse=N20°W
128.58'
A.P. -S39°E 36.50'
21" Hick=S13°W 130.4'

Sayers 1977 Survey

Box & Pipe
Tele Pole=N52°E 32.15'
Tree=N48°W 30.17'
Tree-S70°E 83.85'

1988 LCRC in 2/211

Bar capped #7874
24" Hick.=N49°W 31'
12" Wal=N17°W 82.2
A.P.=S40°E 37'
A.P.= NE 46.2'


B. Description of corner evidence found and/or method applied in restoring or reestablishing corner:

Found 1/2" X 6" Pipe capped #7874 over stone 12" deep in mon. box.
Stone is 0.39°W & 0.14°W of Pipe near surface.
28" Hick = S13°W 130.4'
16" Wal = N17°W 82.2'
Corner is at Q intersection of roadways

RATIFIED BY PEER GROUP
IN ACCORDANCE WITH P.A. 345
ON NOV. 8, 1999
Wayne CO. REPRESENTATIVE

C. Description of monument for corner and accessories established to perpetuate locating the position of the corner:

Set 5/8" x 14" Iron bar w/std. cap in conc. over stone in Mon. box
N & W in E. side 16" Wal. = N17°W 82.20'
N & W in SW side P.P. = N45°E 47.85'
N & W in E. side 28" Hick. = S13°W 130.4'
SE cor. hse. = N20°W 128.58' (to siding)

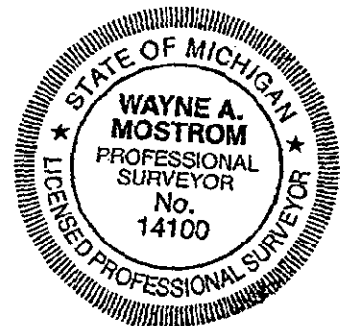

Signed by Wayne A. Mostrom
Surveyor's Michigan License No. 14100

Date November 10, 1999

REMONUMENTATION