

LAND CORNER RECORDATION CERTIFICATE  
 Filing Requirement of Act 74, Mich. P.A. 1970

LIBER 4 PAGE 229

For corners in St. Joseph Located In: \_\_\_\_\_ Corner Code # \_\_\_\_\_  
 (County)

1. Public Land Survey T 5S R 11W L-7  
 T \_\_\_\_\_ R \_\_\_\_\_  
 T \_\_\_\_\_ R \_\_\_\_\_  
 T \_\_\_\_\_ R \_\_\_\_\_

2. Property Controlling S \_\_\_\_\_ T \_\_\_\_\_ R \_\_\_\_\_  
 in Section S \_\_\_\_\_ T \_\_\_\_\_ R \_\_\_\_\_

3. Miscellaneous S \_\_\_\_\_ T \_\_\_\_\_ R \_\_\_\_\_  
 Property in Sec. S \_\_\_\_\_ T \_\_\_\_\_ R \_\_\_\_\_

4. Lot No. \_\_\_\_\_, Recorded Plat \_\_\_\_\_

5. Private Claims \_\_\_\_\_

STATE OF MICHIGAN  
 ST. JOSEPH COUNTY  
 FILED

18 JUN 96 9:15 A.M.

CYNTHIA JARRATT  
 REGISTER OF DEEDS

Register of Deeds Stamp & File Number

I, Donald C. Andrews, in a field survey on May 30, 1996, do hereby certify that under requirements of P.A. of 1970, the corner points mentioned in lines 1 and 2 above were in conformance with regulations and rules therefore as required in the current manual of survey instructions of the United States Department of the Interior, Bureau of Land Management or by a decree of a Court of Law and/or that the corner points mentioned in lines 3, 4 and 5 above were in conformance with the rules of the Michigan Board of Land Surveyors or a Decree of a Court of Law; established, re-established, monumented, re-monumented, recovered, found as expressed below:

NOTE: Not more than 4 corners, all in the same town and range, may be recorded on this certificate.

A. Description of original monument and accessories and/or subsequent restoration:

GLO Post  
 1878 Bk A, P 275 Stone set midway  
 1961 Sayers found stone (pipe/stone) index shows pipe/box PP NW 79.5', house SE 99.45', 12" twin tree South 59.27',  
 1983 Mostrom found 3/4" pipe in mon box: PP N40°W 80.5', PP S46°E 47', 14" dbl Oak South 60'

A	B	C	D	E	F	G	H	I	J	K	L	M
2	6	5	4	3	2	1						
3												
4	7	8	9	10	11	12						
5												
6	18	17	16	15	14	13						
7												
8	19	20	21	22	23	24						
9												
10	30	29	28	27	26	25						
11												
12	31	32	33	34	35	36						
13												

B. Description of corner evidence found and/or method applied in restoring or reestablishing corner:

found 1/2" I.D. PIPE x 36" in mon. box. removed mon box and found stone plumbed with "x" on top. Laid stone on angle so could set iron at point identified by the "x". (note pipe was set along the side of the stone). The "x" stone was accepted as being the corner by the peer group.

SURVEY &  
 REMONUMENTATION


OCT 03 1996

COMMISSION

RATIFIED BY PEER GROUP  
 IN ACCORDANCE WITH P.A. 345  
 ON MAY 13, 1996  
W. Buss CO. REPRESENTATIVE

C. Description of monument for corner and accessories established to perpetuate locating the position of the corner:

5/8" iron x 24" with standard alum. cap:  
 P.P. N45°W 74.46'  
 U.P. N40°W 80.55'  
 U.P. S50°E 46.38'  
 8" MAPLE SOUTH 92.84'

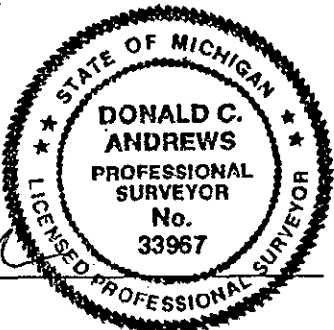

Signed by Donald C. Andrews Date 5/31/96  
 Donald C. Andrews, P.S.

Surveyor's Michigan License No. 33967

LIBER 4 PAGE 229