

LAND CORNER RECORDATION CERTIFICATE  
 Filing Requirement of Act 74, Mich. P.A. 1970

LIBER 4 PAGE 228

For corners in  
 St. Joseph Located In: Corner Code #  
 (County)

1. Public Land Survey T 5S R 11W M-3  
 T R  
 T R  
 T R

2. Property Controlling S T R  
 in Section S T R  
 3. Miscellaneous S T R  
 Property in Sec. S T R

4. Lot No. , Recorded Plat  
 5. Private Claims

STATE OF MICHIGAN  
 ST. JOSEPH COUNTY  
 FILED

18 JUN 96 9:15 A.M.

CYNTHIA JARRATT  
 REGISTER OF DEEDS

Register of Deeds Stamp & File Number

I, Donald C. Andrews, in a field survey on May 30, 1996, do hereby certify that under requirements of P.A. of 1970, the corner points mentioned in lines 1 and 2 above were in conformance with regulations and rules therefore as required in the current manual of survey instructions of the United States Department of the Interior, Bureau of Land Management or by a decree of a Court of Law and/or that the corner points mentioned in lines 3, 4 and 5 above were in conformance with the rules of the Michigan Board of Land Surveyors or a Decree of a Court of Law; established, re-established, monumented, re-monumented, recovered, found as expressed below:

NOTE: Not more than 4 corners, all in the same town and range, may be recorded on this certificate.

A. Description of original monument and accessories and/or subsequent restoration:

GLO Post

	A	B	C	D	E	F	G	H	I	J	K	L	M
2	6	5	4	3	2	1							
3													
4	7	8	9	10	11	12							
5													
6	18	17	16	15	14	13							
7													
8	19	20	21	22	23	24							
9													
10	30	29	28	27	26	25							
11													
12	31	32	33	34	35	36							
13													

B. Description of corner evidence found and/or method applied in restoring or reestablishing corner:

Found 3/4" x24" pipe in monument box. Removed mon box and found below pipe 33" deep a pointed stone. Peer group accepted pointed stone as best evidence as to the location of the corner point.

SURVEY &  
 RE-MONUMENTATION

OCT 03 1996


COMMISSION

RATIFIED BY PEER GROUP  
 IN ACCORDANCE WITH P.A. 345  
 ON MAY 13, 1996  
 W. CO. REPRESENTATIVE

C. Description of monument for corner and accessories established to perpetuate locating the position of the corner:

Set 5/8" x 24" iron with capped iron over stone in monument box:  
 36" maple S40°E 48.84'  
 36" maple N50°E 35.73'  
 BM-13WPR N40°E 53.67'  
 P.P. N65°W 64.62'  
 3/4" pipe in mon. box South 27.58'

Signed by Donald C. Andrews, P.S.  
 Surveyor's Michigan License No. 33967

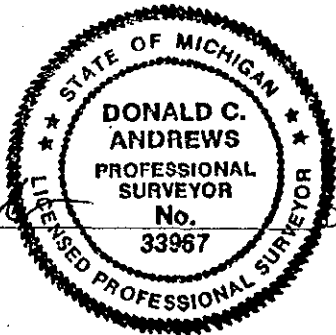

Date 5/31/96

LIBER 4 PAGE 228