

LAND CORNER RECORDATION CERTIFICATE
Filing Requirement of Act 74, Mich. P.A. 1970
St. Joseph County Remonumentation

For corners in

ST. JOSEPH
 Code # _____
 (County)

Located In:

Corner

1. Public Land Survey T 5S R 12W C-7
 T _____ R _____
 T _____ R _____
 T _____ R _____

2. Property Controlling S _____ T _____ R _____
 in Section S _____ T _____ R _____

3. Miscellaneous S _____ T _____ R _____
 Property in Sec. S _____ T _____ R _____

**SURVEY &
 REMONUMENTATION**

JAN 31 2001

LIBER 6 PAGE 59

STATE OF MICHIGAN
 ST. JOSEPH COUNTY
 FILED

1 AUG 2000 9:59:39 AM

CYNTHIA L. JARRATT
 REGISTER OF DEEDS

Register of Deeds Stamp & File Number

SECTION

4. Lot No. _____, Recorded Plat _____
 5. Private Claims _____


I, DALE L. KESLER, in a field survey on JULY 5, 2000 do hereby state that under requirements of P.A. 74, Michigan P.A. of 1970, the corner points mentioned in lines 1 and 2 above were in conformance with regulations and rules therefore as required in the current manual of survey instructions of the United States Department of the Interior, Bureau of Land Management or by a decree of a Court of Law and/or that the corner points mentioned in lines 3, 4 and 5 above were in conformance with the rules of the Michigan Board of Land Surveyors or by a Decree of a Court of Law; established, re-established, monumented, recovered, found as expressed below:

NOTE: Not more than 2 corners, all in the same town and range, may be recorded on this certificate.

A. Description of original monument and accessories and/or subsequent restoration:

| | |
|---------------------------------------|---|
| GLO trees | 1870 Gardner-Found stk by original bearing |
| Set post | 1871 K. Mose-Stk set by original bearing |
| 12" cherry S 66 1/2 E (17.82 bearing) | 1876 Norman & Andrews-found stk by original bearing |
| 16" Ash S 85 deg W 7 (4.62) | 1876 Norman & Andrews-found stk by original bearing |
| No date given-Sayers | 12/29/81 Sayers-Found capped iron |
| Found axel shaft & brick | PP N 80 E 24.07 |
| House corner NW 65.8 | 24" walnut N 50 deg E 35.52 |
| 30" oak NW 38.78 | 20" maple N 50 deg W 52.55 |
| 28" maple NW 51.91 | |
| 6" tree SW 31.17 | 3/23/82 Gove & Associates-Found capped iron |
| 6" tree E 18.3 | PP N 80 deg E 24.07 |
| 30" walnut NE 35.15 | 24" walnut N 50 deg E 35.52 |
| | 20" maple N 50 deg W 52.55 |

**RATIFIED BY PEER GROUP
 IN ACCORDANCE WITH P.A. 345
 ON JULY 10, 2000
W. C. CO. REPRESENTATIVE**

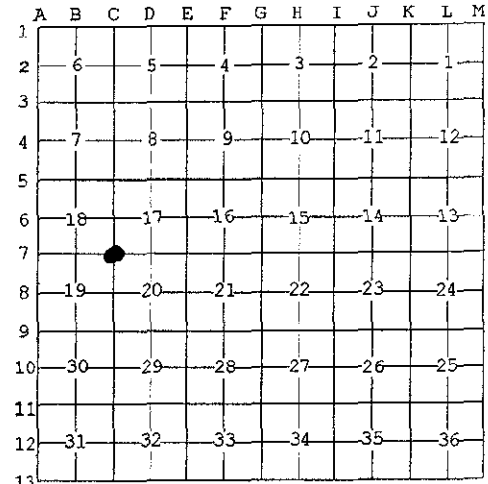

B. Description of corner evidence found and/or method applied in restoring or reestablishing corner:

Found 3/4" iron rebar, removed dug below found stone with "+" in monument box. The existing witnesses (Power pole and 28" maple from Sayers 1981 survey and power pole from Hunt's 1988 survey) measured within reason.


C. Description of monument for corner and accessories established to perpetuate locating the position of the corner:

Found axel shaft in bricks in monument box. Set 5/8" rebar 24" long with aluminum cap in monument box and is a careful and faithful perpetuation of the position of the original corner..

PK nail w/washer in Southside of PP N 80 deg E 24.07
 PK nail w/Washer in Southside of 27" Maple N 50 deg W 52.55
 SE corner Brick House N 49 deg 30 deg W 77.6
 PK nail w/Washer in PP N 78 deg E 73.0'
 C/L asphalt road N & S East 1.85'

Signed by Dale L. Kesler
 Michigan License No. 38117

Date 7-28-00 Surveyor's

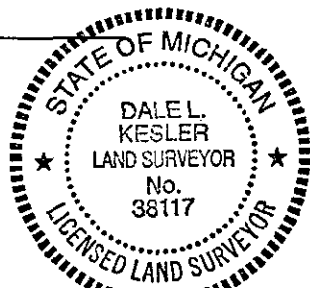

FORM APPROVED BY MICHIGAN STATE BOARD OF PROFESSIONAL SURVEYORS, JAN. 28, 1971
 REVISED MAY 14, 1975
 REVISED JAN., 1983
 REVISED OCT., 1995

DEMONUMENTATION

LIBER 6 PAGE 59

12/2/83 Mostrum frnd capped iron
PP N 80 deg E 24.07
24" walnut N 50 deg E 35.52
20" maple N 50 deg W 52.55

LIBER 6 PAGE 60

9/7/88 John Hunt
Recorded Liber 2, Page 225
Found iron pipe capped
PP W 49.55
PP N 80 deg E 24.07
24" Walnut N 50 deg E 35.52

**SURVEY &
REMONUMENTATION**

JAN 31 2001

SECTION

