

**SURVEY & REMONUMENTATION**

NOV 30 1993

004 PG 005

**LAND CORNER RECORDATION CERTIFICATE**  
 Filing Requirement of Act 74, Mich. P.A. 1970

**COMMISSION**

FILED

corners in  
 ST. JOSEPH (County) Located In: Corner Code #/ #  
 FLOWERFIELD TWP. T 5S R 12W H-9  
 Public Land Survey T R  
 T R  
 T R  
 Property Controlling S T R  
 in Section S T R  
 Miscellaneous S T R  
 Property in Sec. S T R

JUL 22 2 00 PM '93

*Cynthia R. Janott*  
 REGISTER OF DEEDS  
 ST. JOSEPH MICH

Register of Deeds Stamp & File Number

Lot No. \_\_\_\_\_ Recorded Plat \_\_\_\_\_  
 Private Claims \_\_\_\_\_

	A	B	C	D	E	F	G	H	I	J	K	L	M
2	6	5	4	3	2	1							
3													
4	7	8	9	10	11	12							
5													
6	18	17	16	15	14	13							
7													
8	19	20	21	22	23	24							
9													
10	30	29	28	27	26	25							
11													
12	31	32	33	34	35	36							
13													

WAYNE A. MOSTROM, in a field survey on JUNE 14, 1993, hereby certify that under requirements of P.A. 74, Michigan P.A. of 1970, the corner points mentioned in lines 1 and 2 above were in conformance with regulations and rules therefore as required in the present manual of survey instructions of the United States Department of the Interior, Bureau of Land Management or by a decree of a Court of Law and/or that the corner points mentioned in lines 3, 4 and 5 above were in conformance with the rules of the Michigan Board of Land Surveyors or by a Decree of a Court of Law; established, re-established, monumented, re-monumented, recovered, found as pressed below:

**NOTE: Not more than 4 corners, all in the same town and range, may be recorded on this certificate.**

Description of original monument and accessories and/or subsequent restoration:

0	ROAD COMMISSION - 1960'S	L.-3, P.-37
2" BLK. OAK = S78°E 18 LKS.	(1.) ANCHOR POST = N1°W 25.25'	ACT 74 RECORDS
5" W.O. = N90°E 13 LKS.	(2.) 13" OAK = N64°E 65.5'	(1.) 13" OAK = N64°E 65.50'
386 SURVEY BY TODD (BOOK A, PAGE 538)	(3.) 19" CHERRY = S66°E 46.85'	(2.) 19" CHERRY = S66°E 46.85'
THE S 1/4 COR IS A STONE SET	(4.) 29" OAK = S78°W 120.7'	
BY FORMER SURVEYOR FROM OLD	FOUND STONE OVER REMAINS OF OLD	
29" TREE	STAKE, SET MON BOX	


Description of corner evidence found and/or method applied in restoring or reestablishing corner:

FOUND STONE IN MON BOX  
 VERIFIED FROM EXISTING #1, 2, 3 & 4 FROM 1960'S ROAD COMMISSION  
 WITNESSES ABOVE. GLO REFERENCE TREES ARE OUT!

Description of monument for corner and accessories established to perpetuate locating the position of the corner:

SOUTH 1/4 COR., SEC. 22 - SET 5/8"X24" BAR W/STD CAP IN MON BOX  
 N&W 24" HIGH IN S. SIDE 30" OAK = N64°E 65.50'  
 N&W IN A.P. = N01°W 25.95'  
 N&W 18" HIGH IN N SIDE 31" OAK = S78°W 120.7'  
 N&W 24" HIGH IN E SIDE 17" CHERRY = S05°E 47.76'  
 COR FALLS IN C/L E-W GRAVEL RDWY & IN FEN. LN. TO N&S  
 THIS POSITION REPRESENTS A PERPETUATION OF THE ORIGINAL CORNER

ACCEPTED BY PEER GROUP JUNE 14, 1993

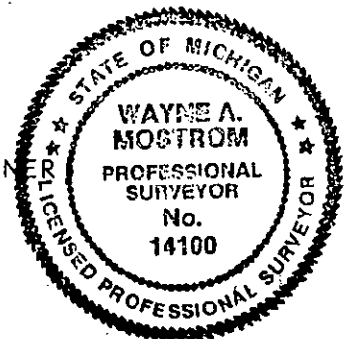

Witnessed by *Wayne A. Mostrom*  
 Surveyor's Michigan License No. 14100

Date 7/8/93