FILED

JUN 27 12 46 PM '94

Cynthia R. Jennett
REGISTER OF DEEDS
ST. JOSEPH COUNTY

004 PG 030

LAND CORNER RECORDATION CERTIFICATE

Filing Requirement of Act 74, Mich. P.A. 1970

For corners in

ST. JOSEPH (County)

FLOWERFIELD TWP.

	Located In:	Corner Code #:
1. Public Land Survey	T 5 S R 12 W	M-11
	T ___ R ___	
	T ___ R ___	
	T ___ R ___	
2. Property Controlling	S ___ T ___ R ___	
in Section	S ___ T ___ R ___	
3. Miscellaneous	S ___ T ___ R ___	
Property in Sec.	S ___ T ___ R ___	

SURVEY & REMONUMENTATION

AUG 31 1994

COMMISSION

Register of Deeds Stamp & File Number

4. Lot No. _____, Recorded Plat _____
5. Private Claims _____

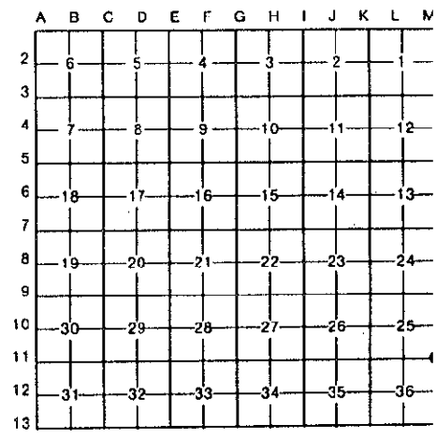

I, DAVID W. MOSTROM, in a field survey on MAY 23, 19 94, do hereby certify that under requirements of P.A. 74, Michigan P.A. of 1970, the corner points mentioned in lines 1 and 2 above were in conformance with regulations and rules therefore as required in the current manual of survey instructions of the United States Department of the Interior, Bureau of Land Management or by a decree of a Court of Law and/or that the corner points mentioned in lines 3, 4 and 5 above were in conformance with the rules of the Michigan Board of Land Surveyors or by a Decree of a Court of Law; established, re-established, monumented, re-monumented, recovered, found as expressed below:

NOTE: Not more than 4 corners, all in the same town and range, may be recorded on this certificate.

A. Description of original monument and accessories and/or subsequent restoration:

(M-11) NORTHEAST CORNER SEC. 36, T5S, R12W

GLO
7" W. OAK = N72°W 46 LKS.
13" Y. OAK = S05°W 39 LKS.

STATE OF MICHIGAN
DAVID W. MOSTROM
PROFESSIONAL SURVEYOR
No. 32339
LICENSED PROFESSIONAL SURVEYOR

B. Description of corner evidence found and/or method applied in restoring or reestablishing corner:

(M-11)

EXCAVATED AREA AT GLO JOG DIST. (35.64') SOUTH OF NW COR. SEC. 31, T5S, R11W. FOUND NO EVIDENCE OF GLO WITNESSES OR CORNER.

RATIFIED BY PEER GROUP
IN ACCORDANCE WITH P.A. 345
ON May 9th ; 1994
[illegible] CO. REPRESENTATIVE

C. Description of monument for corner and accessories established to perpetuate locating the position of the corner:

(M-11) SET 5/8" X 24" IRON W/STANDARD CAP AT GLO JOG DIST. (35.64') SOUTH OF NW COR. OF SEC. 31, T5S, R11W ON PROLONGATION OF EAST ¼ COR. SEC. 25, T5S, R12W AND NW COR. SEC. 31, T5S, R11W

PK NAIL & WASHER 2' HIGH ON S. SIDE OF 10" HICKORY = EAST 39.03'
" 3" HICKORY = WEST 32.97'
PK NAIL & WASHER 2' HIGH ON W. SIDE OF 6" HICKORY = N29°W 4.50'
" S. SIDE OF 18" OAK = S84°E 17.92'

Signed by [signature] Date JUNE 14, 1994

Surveyor's Michigan License No. 32339

FORM APPROVED BY MICHIGAN STATE BOARD OF LAND SURVEYORS, JAN. 28, 197
REVISED MAY 14, 197
REVISED JAN., 198

REMONUMENTATION