

NOV 9 1997

COMMISSION

LAND CORNER RECORDATION CERTIFICATE
Filing Requirement of Act 74, Mich. P.A. 1970

LIBER 5 PAGE 20

For corners in

ST. JOSEPH (County)	Located in:	Corner Code #
COLON TWP.		
1. Public Land Survey	T 6S R 9W	C-3
	T R	
	T R	
	T R	
2. Property Controlling in Section	S T R	
	S T R	
3. Miscellaneous Property in Sec.	S T R	
	S T R	

STATE OF MICHIGAN
ST. JOSEPH COUNTY
FILED

17 SEP 97 3:26 P.M.

CYNTHIA JARRATT
REGISTER OF DEEDS

Register of Deeds Stamp & File Number

4. Lot No. _____, Recorded Plat _____
5. Private Claims _____

I, DAVID W. MOSTROM, in a field survey on SEPT. 6, 19 97 do hereby state that under requirements of P.A. 74, Michigan P.A. of 1970, the corner points mentioned in lines 1 and 2 above were in conformance with regulations and rules therefore as required in the current manual of survey instructions of the United States Department of the Interior, Bureau of Land Management or by a decree of a Court of Law and /or that the corner points mentioned in lines 3, 4 and 5 above were in conformance with the rules of the Michigan Board of Land Surveyors or by a Decree of a Court of Law; established, re-established, monumented, recovered, found as expressed below:

NOTE: Not more than 2 corners, all in the same town and range, may be recorded on this certificate.

A	B	C	D	E	F	G	H	I	J	K	L	M
1												
2	6		5		4		3		2		1	
3		●										
4	7		8		9		10		11		12	
5												
6	18		17		16		15		14		13	
7												
8	19		20		21		22		23		24	
9												
10	30		29		28		27		26		25	
11												
12	31		32		33		34		35		36	
13												

A. Description of original monument and accessories and/or subsequent restoration:

(C-3) CORNER COMMON TO SECTIONS 5, 6, 7 & 8

- *1866 SURVEY IN BK A, PG 144
STAKE FROM OLD BEARING TREES
NOW GREEN
- *1960'S ROAD COMMISSION
1/2" PIPE IN MON. BOX RE-ESTABLISHED
USING SURROUNDING CORNERS
13" BLACK OAK = N55°W 58.62'
29" BLACK OAK = N02°W 48.55'
6" POPLAR = S18°E 67.20'
TELE. POLE = S72°W 59.85'

- *1974 LCRC IN BK 1, PG 59
FOUND 3/4" PIPE IN MON. BOX
RR IRON = NORTH 31.63'
POINTED ROCK = NW 26.3'
ROAD CENTERLINE = SOUTH 1.0'


B. Description of corner evidence found and/or method applied in restoring or reestablishing corner:

- (C-3)
FOUND 3/4" PIPE IN MON. BOX
DEAD 20" BLACK OAK = N55°W 58.62'
STUMP OF BLACK OAK = N02°W 48.55'
CORNER FALLS IN C OF ORLA ENGLE ROAD
CORNER FALLS IN PROJ. OF FENCE TO NORTH &
1.0' WEST OF PROJ. OF FENCE TO SOUTH

RATIFIED BY PEER GROUP
IN ACCORDANCE WITH P.A. 345
ON SEPT. 8, 1997
W. CO. REPRESENTATIVE

C. Description of monument for corner and accessories established to perpetuate locating the position of the corner:

- (C-3) CORNER COMMON TO SECTIONS 5, 6, 7 & 8
SET 5/8" X 24" IRON BAR W/STD. CAP IN PLACE OF 3/4" PIPE IN MON. BOX
N & W 2.0' HIGH IN W. SIDE OF 12" OAK = S13°E 33.20'
N & W 2.0' HIGH IN W. SIDE OF 5" POPLAR = S29°W 35.10'
N & W 2.0' HIGH IN W. SIDE OF 5" OAK = NORTH 32.25'
R.R. RAIL ANCHOR POST = S02°W 33.50' (CENTER 2.0' HIGH)

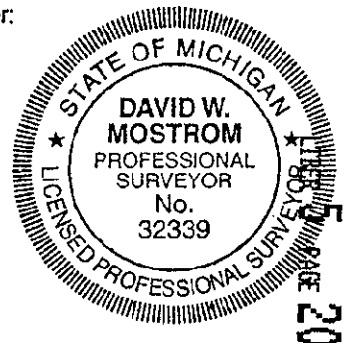

Signed by [Signature]
Surveyor's Michigan License No. 32339

Date SEPTEMBER 9, 1997