

SURVEY & REMONUMENTATION

MAY 05 1995

COMMISSION

LAND CORNER RECORDATION CERTIFICATE

Filing Requirement of Act 74, Mich. P.A. 1970 LIBER 4 PAGE 93

For corners in

<u>ST. JOSEPH COUNTY</u> (County)		Located In:	Corner Code #
<u>COLON TOWNSHIP</u>			
1. Public Land Survey	T <u>6S</u> R <u>9W</u>		<u>D-7</u>
	T _____ R _____		_____
	T _____ R _____		_____
	T _____ R _____		_____
2. Property Controlling in Section	S _____ T _____ R _____		_____
	S _____ T _____ R _____		_____
3. Miscellaneous Property in Sec.	S _____ T _____ R _____		_____
	S _____ T _____ R _____		_____
4. Lot No. _____, Recorded Plat _____			
5. Private Claims _____			

STATE OF MICHIGAN
ST. JOSEPH COUNTY
FILED

19 JAN 95 10:53 A.M.

CYNTHIA JARRATT
REGISTER OF DEEDS

Register of Deeds Stamp & File Number

I, DAVID W. MOSTROM in a field survey on DECEMBER 28, 19 94, do hereby certify that under requirements of P.A. 74, Michigan P.A. of 1970, the corner points mentioned in lines 1 and 2 above were in conformance with regulations and rules therefore as required in the current manual of survey instructions of the United States Department of the Interior, Bureau of Land Management or by a decree of a Court of Law and/or that the corner points mentioned in lines 3, 4 and 5 above were in conformance with the rules of the Michigan Board of Land Surveyors or by a Decree of a Court of Law; established, re-established, monumented, re-monumented, recovered, found as expressed below:

A	B	C	D	E	F	G	H	I	J	K	L	M
2	6	5	4	3	2	1						
3												
4	7	8	9	10	11	12						
5												
6	18	17	16	15	14	13						
7		●										
8	19	20	21	22	23	24						
9												
10	30	29	28	27	26	25						
11												
12	31	32	33	34	35	36						
13												

NOTE: Not more than 4 corners, all in the same town and range, may be recorded on this certificate.

A. Description of original monument and accessories and/or subsequent restoration:
(D-7) 1/4 CORNER COMMON TO SECTIONS 17 & 20

GLO
BOTH WITNESSES ARE OUT

MARCH 17, 1886 SURVEY IN BK. A. PG. 494

STONE SET FROM ORIGINAL BEARINGS
NO WITNESSES

MARCH 29, 1886 SURVEY IN BK A, PG. 502

CORNER NOT LABELED

1965 ROAD COMMISSION

LARGE +'D STONE OVER
OVER WOOD STAKE IN
MONUMENT BOX

SE COR. HSE. =
N41°W 93.11'
ANCHOR POST =
N01°E 26.55'
ANCHOR POST =
S60°W 56.35'

B. Description of corner evidence found and/or method applied in restoring or reestablishing corner:

(D-7)


FOUND 3/4" PIPE OVER STONE IN MON. BOX
SE COR. HSE = N41°W 93.11'
ANCHOR POST = N01°E 26.55'
ANCHOR POST = S60°W 56.35'

RATIFIED BY PEER GROUP
IN ACCORDANCE WITH P.A. 345
ON JAN. 9, 1995
Wan CO. REPRESENTATIVE

C. Description of monument for corner and accessories established to perpetuate locating the position of the corner:

(D-7)

SET 5/8" X 24" IRON BAR W/STD. CAP OVER STONE IN MON. BOX
SE COR. HOUSE = N41°W 93.11'
NE COR. HOUSE = N30°W 121.86'
NE COR. OF GARAGE = N27°W 171.91'
TELE. POLE = S58°W 50.07'
FENCELINE PROJ. TO NORTH = EAST 1.0'
CL ROAD = NORTH 1.0'

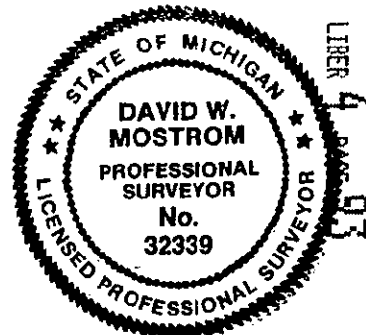

Signed by J. W. Mostrom

Date JANUARY 11, 1995

Surveyor's Michigan License No. 32339

rd in 1995

REMONUMENTATION