

LAND CORNER RECORDATION CERTIFICATE
Filing Requirement of Act 74, Mich. P.A. 1970

For corners in
ST. JOSEPH
COLON TWP. (County)

Located In:

Corner Code #

LIBER 4 PAGE 236

STATE OF MICHIGAN
ST. JOSEPH COUNTY
FILED

6 AUG 96 3:42 P.M.

CYNTHIA JARRATT
REGISTER OF DEEDS

Register of Deeds Stamp & File Number

1. Public Land Survey	T 6 S R 9 W	E-2
	T R	
	T R	
	T R	
2. Property Controlling In Section	S T R	
	S T R	
3. Miscellaneous Property in Section	S T R	
	S T R	

4. Lot No. _____, Recorded Plat _____
5. Private Claims _____

A	B	C	D	E	F	G	H	I	J	K	L
2	6	5	4	3	2						
3											
4	7	8	9	10	11	12					
5											
6	18	17	16	15	14	13					
7											
8	19	20	21	22	23	24					
9											
10	30	29	28	27	26	25					
11											
12	31	32	33	34	35	36					
13											

I, DAVID W. MOSTROM, in a field survey on APRIL 8, 1996, do hereby certify that under requirements of P.A. 74, Michigan P.A. of 1970, the corner points mentioned in lines 1 and 2 above were in conformance with regulations and rules therefore as required in the current manual of survey instructions of the United States Department of the Interior, Bureau of Land Management or by a decree of a Court of Law and/or that the corner points mentioned in lines 3, 4 and 5 above were in conformance with the rules of the Michigan Board of Professional Surveyors or by a Decree of a Court of Law; established, re-established, monumented, re-monumented, recovered, found as expressed below:

NOTE: Not more than 4 corners, all in the same town and range, may be recorded on this certificate.

A. Description of original monument and accessories and/or subsequent restoration:
(E-2) 1/4 CORNER BETWEEN SECTIONS 4 & 5 T6S, R9W

GLO
24" W. OAK = S57°W 40.92'
10" HICKORY = N14 1/2°E 27.72'
14" HICKORY = N09°E 47.0'
ANCHOR POST = S02°E 21.35'

1975 LCRC IN BK 3, PG 41
1976 LCRC IN BK 2, PG 85A
FOUND PIPE IN MON. BOX
14" HICKORY = NORTH 46.68'
POST = SOUTH 32.03'

1963 ROAD COMMISSION
LARGE POINTED STONE UNDER 1/2" PIPE
IN MONUMENT BOX
24" HICKORY = N57°W 50.35'

SURVEY &
MONUMENTATION

OCT 08 1996

COMMISSION


B. Description of corner evidence found and/or method applied in restoring or reestablishing corner:

(E-2)
FOUND 1/2" X 30" LONG PIPE IN MON. BOX
CORNER FALLS 1.3' SOUTH OF ROAD CENTERLINE
CORNER FALLS IN LINE WITH FENCE TO NORTH &
1' WEST OF FENCE TO SOUTH
PK IN ANCHOR POST = SOUTH 32.20'
REMAINS OF HICKORY STUMP = N05°E 47'
2' CUT ON NORTH SIDE OF ROAD & 2' FILL ON
SOUTH SIDE OF ROAD

RATIFIED BY PEER GROUP
IN ACCORDANCE WITH P.A. 345
ON MAY 13, 1996
Worm CO. REPRESENTATIVE

C. Description of monument for corner and accessories established to perpetuate locating the position of the corner:

(E-2) 1/4 CORNER BETWEEN SECTIONS 4 & 5 T6S, R9W
SET 5/8" X 24" IRON BAR W/STD. CAP IN PLACE OF 1/2" PIPE
ANCHOR POST = NORTH 32.45'
ANCHOR POST = SOUTH 32.44'
FENCE POST = S36°E 41.24'
FENCE POST = N15°W 33.71'
N & W IN SW SIDE OF 12" CHERRY = N35°W 47.50'
N & W IN NE SIDE OF 10" CHERRY = N12°W 40.13'
N & W W. SIDE OF 4" HICKORY = S04°W 32.00'

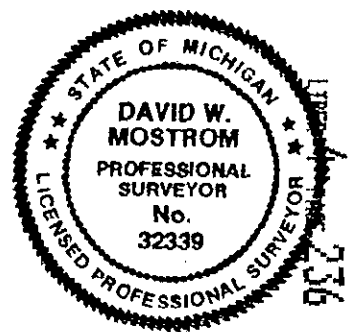

Signed by J. W. Mostrom
Surveyor's Michigan License No. 32339

Date JULY 29, 1996

FORM APPROVED BY MICHIGAN STATE BOARD OF PROFESSIONAL SURVEYORS, JAN. 28, 1971
REVISED MAY 14, 1975
REVISED JAN., 1983

REMONUMENTATION