

SURVEY & REMONUMENTATION

MAY 05 1995

COMMISSION

LAND CORNER RECORDATION CERTIFICATE

Filing Requirement of Act 74, Mich. P.A. 1970 LIBER 4 PAGE 114

For corners in

ST. JOSEPH (County)	Located In:	Corner Code #
COLON TWP.		
1. Public Land Survey	T 6 S R 9 W	F-13
	T R	
	T R	
	T R	
2. Property Controlling in Section	S T R	
	S T R	
3. Miscellaneous Property in Sec.	S T R	
	S T R	

STATE OF MICHIGAN
ST. JOSEPH COUNTY
FILED

4 APR 95 9:49 A.M.

CYNTHIA JARRATT
REGISTER OF DEEDS
Register of Deeds Stamp & File Number

4. Lot No. _____, Recorded Plat _____
5. Private Claims _____

	A	B	C	D	E	F	G	H	I	J	K	L	M
2	5		5		4		3		2				
3													
4	7		8		9		10		11		12		
5													
6	18		17		16		15		14		13		
7													
8	19		20		21		22		23		24		
9													
10	30		29		28		27		26		25		
11													
12	31		32		33		34		35		36		
13													

I, DAVID W. MOSTROM, in a field survey on JANUARY 19, 19 95, do hereby certify that under requirements of P.A. 74, Michigan P.A. of 1970, the corner points mentioned in lines 1 and 2 above were in conformance with regulations and rules therefore as required in the current manual of survey instructions of the United States Department of the Interior, Bureau of Land Management or by a decree of a Court of Law and/or that the corner points mentioned in lines 3, 4 and 5 above were in conformance with the rules of the Michigan Board of Land Surveyors or by a Decree of a Court of Law; established, re-established, monumented, re-monumented, recovered, found as expressed below:

NOTE: Not more than 4 corners, all in the same town and range, may be recorded on this certificate.

A. Description of original monument and accessories and/or subsequent restoration:

(F-13) SOUTH ¼ CORNER SEC. 33, T6S, R9W

GLO POST

1964 ROAD COMM.

CORNER RECORDS IN BOOK 3, PG. 49

5" MAPLE = N52°E 70 LKS.
20" OAK = N86°W 2.73 CH.

½" PIPE IN MON. BOX - RE ESTABLISHED
W. EDGE BRIDGE = EAST 102.11'
25" SYCAMORE = S02°W 64.38'

BOX & PIPE
TRIPLE MAPLE = SW 25.5'
C ROAD = NORTH 2.3'

1867 SURVEY IN BK. A,
PG. 148

39" MAPLE = N21°W 77.34'
SET BY DOUBLING OVER CORNERS
¼ MILE & ½ MILE EAST

STAKE FROM ORIG. BRG. TREE
16" W. MAPLE=N52°E 70 LKS.

B. Description of corner evidence found and/or method applied in restoring or reestablishing corner:

(F-13)

FOUND ½" PIPE IN MON. BOX IN C OF E-W ROAD

48" MAPLE = N21°W 77.34'

CORNER FALLS 0.56' EAST OF DOUBLE OVER DISTANCE
FROM CORNERS ¼ MILE AND ½ MILE EAST

RATIFIED BY PEER GROUP
IN ACCORDANCE WITH P.A. 345
ON MARCH 13, 1995
Mostrom CO. REPRESENTATIVE

C. Description of monument for corner and accessories established to perpetuate locating the position of the corner:

(F-13) SOUTH ¼ CORNER SEC. 33, T6S, R9W

SET 5/8" X 24" IRON BAR W/STD. CAP IN MON. BOX IN PLACE OF ½" PIPE

W. EDGE BRIDGE = EAST 92.2'

NORTH ¼ COR. SEC. 4, T7S, R9W = WEST 81.54'


N & W 5' HIGH IN W. SIDE OF 14" POPLAR = N07°W 37.55'

N & W 5' HIGH IN W. SIDE OF 12" POPLAR = N42°E 59.73'

N & W 2' HIGH IN NE SIDE OF 12" ASH = S53°E 43.67'

N & W 4' HIGH IN E. SIDE OF 12" ASH = S02°W 32.89'

N & W 1' HIGH IN W. SIDE OF 48" MAPLE = N21°W 77.34'

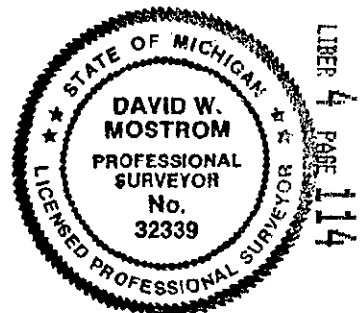

Signed by J.W. Mostrom

Date MARCH 24, 1995

Surveyor's Michigan License No. 32339

REMONUMENTATION