

**SURVEY & REMONUMENTATION**  
**APR 10 1995**  
**COMMISSION**

**LAND CORNER RECORDATION CERTIFICATE**  
**Filing Requirement of Act 74, Mich. P.A. 1970**

**LIBER 4 PAGE 91**

For corners in

ST. JOSEPH  
(County)  
COLON TOWNSHIP

Located In:

Corner Code ##

- |                                    |                         |            |
|------------------------------------|-------------------------|------------|
| 1. Public Land Survey              | T <u>6S</u> R <u>9W</u> | <u>I-6</u> |
|                                    | T _____ R _____         | _____      |
|                                    | T _____ R _____         | _____      |
|                                    | T _____ R _____         | _____      |
| 2. Property Controlling in Section | S _____ T _____ R _____ | _____      |
|                                    | S _____ T _____ R _____ | _____      |
| 3. Miscellaneous Property in Sec.  | S _____ T _____ R _____ | _____      |
|                                    | S _____ T _____ R _____ | _____      |
4. Lot No. \_\_\_\_\_, Recorded Plat \_\_\_\_\_
5. Private Claims \_\_\_\_\_

STATE OF MICHIGAN  
 ST. JOSEPH COUNTY  
 FILED

19 JAN 95 10:51 A.M.

CYNTHIA JARRATT  
 REGISTER OF DEEDS

Register of Deeds Stamp & File Number

I, DAVID W. MOSTROM, in a field survey on NOV. 25, 19 94, do hereby certify that under requirements of P.A. 74, Michigan P.A. of 1970, the corner points mentioned in lines 1 and 2 above were in conformance with regulations and rules therefore as required in the current manual of survey instructions of the United States Department of the Interior, Bureau of Land Management or by a decree of a Court of Law and/or that the corner points mentioned in lines 3, 4 and 5 above were in conformance with the rules of the Michigan Board of Land Surveyors or by a Decree of a Court of Law; established, re-established, monumented, re-monumented, recovered, found as expressed below:

A	B	C	D	E	F	G	H	I	J	K	L	M
2	6	5	4	3	2	1						
3												
4	7	8	9	10	11	12						
5												
6	18	17	16	15	14	13						
7												
8	19	20	21	22	23	24						
9												
10	30	29	28	27	26	25						
11												
12	31	32	33	34	35	36						
13												

**NOTE: Not more than 4 corners, all in the same town and range, may be recorded on this certificate.**

A. Description of original monument and accessories and/or subsequent restoration:

**(I-6) 1/4 CORNER COMMON TO SECTIONS 14 & 15**

**GLO - POST**  
 8" W. OAK = N29 3/4°W 115.5'  
**1903 & 1904 SURVEYS IN**  
**BOOK B, PG. 104 & BOOK 1, PG. 99**  
 + 'D STONE  
 24" W. OAK = N29 3/4°W 115.5'

**1974 SAYERS SURVEY &**  
**LCRC IN BK. 1, PG. 97**  
 SET IRON BAR OVER + 'D STONE  
 RR RAIL = NORTH 33'

**1992 LCRC IN BK. 3, P. 229**  
 SET CAPPED IRON #27456 FROM  
 RR RAIL  
 P. POLE = N40°W 38.78'  
 P. POLE = N40°E 68.50'  
 WATER VALUE BOX = N80°E 42.95'  
 RR RAIL = NORTH 33.00'


B. Description of corner evidence found and/or method applied in restoring or reestablishing corner:

**(I-6)**  
 FOUND CAPPED IRON #27456 OVER CAPPED IRON #7874  
 OVER + 'D STONE 36" DEEP  
 52" W. OAK = N30°W 115.50'  
 CUT OFF R.R. RAIL IN CONC. = NORTH 33'  
 4 WITNESSES FROM LCRC IN BK. 3, P. 229 ARE IN & OK

**RATIFIED BY PEER GROUP**  
**IN ACCORDANCE WITH P.A. 345**  
 ON DEC. 12, 1994  
W. M. CO. REPRESENTATIVE

C. Description of monument for corner and accessories established to perpetuate locating the position of the corner:

**(I-6) 1/4 CORNER COMMON TO SECTIONS 14 & 15**  
 SET 5/8" X 24" IRON W/STD. CAP OVER + 'D STONE FOUND IN MON. BOX  
 N & W 2' HIGH ON SW SIDE OF P. POLE = N40°W 39.20'  
 N & W 2' HIGH ON SE SIDE OF P. POLE = N40°E 68.70'  
 N & W 2' HIGH ON NE SIDE OF 52" W. OAK = N30°W 115.50'  
 N & W 2' HIGH ON S SIDE OF P. POLE = EAST 105.60'  
 PROJ. OF ROAD CL TO EAST = NORTH 32'  
 PROJ. OF ROAD CL TO SOUTH = WEST 1.0'

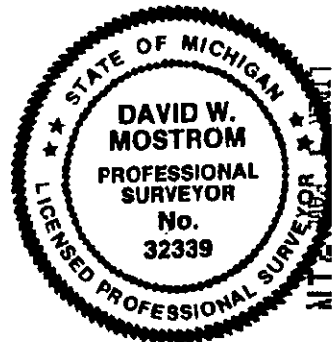

Signed by J. W. Mostrom Date JANUARY 3, 1995  
 Surveyor's Michigan License No. 32339

**REMONUMENTATION**