

LAND CORNER RECORDATION CERTIFICATE

Filing Requirement of Act 74, Mich. P.A. 1970

For corners in

ST. JOSEPH  
(County)

Located in:

Corner Code #

LIBER 4 PAGE 234


COLON TWP.

- |                                      |   |    |   |    |     |
|--------------------------------------|---|----|---|----|-----|
| 1. Public Land Survey                | T | 6S | R | 9W | I-9 |
|                                      | T |    | R |    |     |
|                                      | T |    | R |    |     |
|                                      | T |    | R |    |     |
| 2. Property Controlling in Section   | S |    | T | R  |     |
|                                      | S |    | T | R  |     |
| 3. Miscellaneous Property in Section | S |    | T | R  |     |
|                                      | S |    | T | R  |     |
4. Lot No. \_\_\_\_\_, Recorded Plat \_\_\_\_\_
5. Private Claims \_\_\_\_\_

STATE OF MICHIGAN  
ST. JOSEPH COUNTY  
FILED

6 AUG 96 3:41 P.M.

CYNTHIA JARRATT  
REGISTER OF DEEDS  
Register of Deeds Stamp & File Number

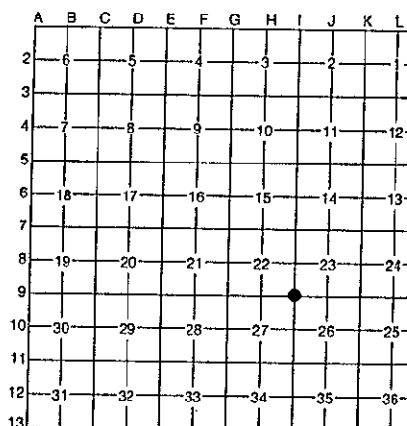

I, DAVID W. MOSTROM, in a field survey on APRIL 8, 1996, do hereby certify that under requirements of P.A. 74, Michigan P.A. of 1970, the corner points mentioned in lines 1 and 2 above were in conformance with regulations and rules therefore as required in the current manual of survey instructions of the United States Department of the Interior, Bureau of Land Management or by a decree of a Court of Law and/or that the corner points mentioned in lines 3, 4 and 5 above were in conformance with the rules of the Michigan Board of Professional Surveyors or by a Decree of a Court of Law; established, re-established, monumented, re-monumented, recovered, found as expressed below:

NOTE: Not more than 4 corners, all in the same town and range, may be recorded on this certificate.

A. Description of original monument and accessories and/or subsequent restoration:

(I-9) CORNER COMMON TO SECTIONS 22, 23, 26 & 27

- |                                   |                                |                               |
|-----------------------------------|--------------------------------|-------------------------------|
| 1865 SURVEY IN BOOK A, PAGE 96    | 1960 ROAD COMMISSION           | MON. BOX OVER PIPE            |
| STAKE - ORIG. BRG. TREE NOW GREEN | STONE UNDER MON. BOX           | NW. HOUSE COR. = SE. 88.50'   |
| 16" W. OAK = S63°W 11.88'         | FENCE POST = NORTH 28.5'       | P. POLE = NW. 44.20'          |
| 1880 SURVEY IN BOOK A, PAGE 344   | 23" MAPLE = S36°E 35.8'        | TEL. POLE = SW. 46.9'         |
| STONE FROM OLD BEARING            | NW COR. CHIMNEY = S63°E 97.55' | 1979 LCRC IN BOOK 2, PAGE 111 |
| 4" HICKORY = S88°10'W 89.76'      | 1975 LCRC IN BOOK E, PAGE 47 & | 3/4" PIPE IN MON. BOX         |
|                                   | 1976 LCRC IN BOOK 3, PAGE 46   | 30" MAPLE = SE. 50.10'        |
|                                   |                                | P. POLE = NW. 44.0'           |

B. Description of corner evidence found and/or method applied in restoring or reestablishing corner:

(I-9)

FOUND 1/2" X 10" IRON PIPE OVER STONE 14" DEEP IN MON. BOX  
NW COR. CHIMNEY = S63°E 97.45'  
NW COR. HOUSE = SE 88.60'  
P. POLE = NW. 44.5' OR 44.0' TO FACE  
CORNER FALLS IN PROJ. OF ROAD TO SOUTH

TEL. POLE = SW. 46.7'  
IN PROJ. OF ROADWAY TO SOUTH

RATIFIED BY PEER GROUP  
IN ACCORDANCE WITH P.A. 345  
ON MAY 13, 1996  
Mostrom CO. REPRESENTATIVE

C. Description of monument for corner and accessories established to perpetuate locating the position of the corner:

(I-9) CORNER COMMON TO SECTIONS 22, 23, 26 & 27

SET 5/8" X 10" BAR W/STD. CAP IN CONC. OVER STONE IN MON. BOX  
NW. CORNER HOUSE = S57°E 88.60  
NE. CORNER GARAGE = S51°W 113.20'  
NW. CORNER CHIMNEY = S59°E 97.45'  
N & W IN E. SIDE OF P. POLE = N02°W 44.47'  
N & W IN SE. SIDE OF 12" MAPLE = N60°E 92.76'  
CORNER FALLS IN PROJ. OF ROAD TO SOUTH & EAST  
AND 4' SOUTH OF ROAD TO WEST



LIBER 4 PAGE 234

Signed by [Signature]  
Surveyor's Michigan License No. 32339

Date SEPTEMBER 8, 1996

FORM APPROVED BY MICHIGAN STATE BOARD OF PROFESSIONAL SURVEYORS, JAN. 28, 1971  
REVISED MAY 14, 1975  
REVISED JAN., 1983

REMONUMENTATION OCT 03 1996

COMMISSION