

**LAND CORNER RECORDATION CERTIFICATE**  
**Filing Requirement of Act 74, Mich. P.A. 1970**

**LIBER 6 PAGE 24**

STATE OF MICHIGAN  
 ST. JOSEPH COUNTY  
 FILED

29 MAR 2000 10:14:34 AM

CYNTHIA L. JARRATT  
 REGISTER OF DEEDS

Register of Deeds Stamp & File Number

For corners in Nottawa Township

St. Joseph County Located In: Corner Code #  
 (County)

1. Public Land Survey T6S R10W C-3  
 T R  
 T R **SURVEY &**  
 T R **REMONUMENTATION**  
 2. Property Controlling S T R  
 in Section S T R **JAN 31 2001**  
 3. Miscellaneous S T R  
 Property in Sec. S T R  
**SECTION**

4. Lot No. \_\_\_\_\_, Recorded Plat \_\_\_\_\_  
 5. Private Claims \_\_\_\_\_

I, Wayne A. Mostrom, in a field survey on Feb. 28, 2000, do state that under requirements of P.A. 74, Michigan P.A. of 1970, the corner points mentioned in lines 1 and 2 above were in conformance with regulations and rules therefore as required in the current manual of survey instructions of the United States Department of the Interior, Bureau of Land Management or by a degree of a Court of Law and/or that the corner points mentioned in lines 3, 4 and 5 above were in conformance with the rules of the Michigan Board of Land Surveyors or by a Decree of a Court of Law, established, re-established, monumented, recovered, found as expressed below.

NOTE: Not more than 2 corners, all in the same town and range, may be recorded on this certificate.

	A	B	C	D	E	F	G	H	I	J	K	L	M
1													
2	6		5		4		3		2		1		
3			⊙										
4	7		8		9		10		11		12		
5													
6	18		17		16		15		14		13		
7													
8	19		20		21		22		23		24		
9													
10	30		29		28		27		26		25		
11													
12	31		32		33		34		35		36		
13													

A. Description of original monument and accessories and/or subsequent restoration:

<u>Road Commission - 1958</u> Long pointed stone in Mon. box A.P. = S45°E 35.35' NW cor. Br. Hse. = S45°E 99.85' 26" Maple = S15°E 103.67'	<u>1958 - "Vorstland Acres"</u> Cor. is SW corner of Plat  <u>1968 - "Spring Haven Sub."</u> Plat shows mon. 33' West	<u>1983 Sayers Survey</u> Box w/l.P. 30" Maple = S60°E 46.5' 12" Cedar = S45°E 37.5' Tele. J-box = S70°W 27.6'	<u>Mostrom 1984 Survey</u> 3/4" pipe in Mon. box NW cor. Br. Hse. = S45°E 99.85' 26" Maple = S15°E 103.67' CL rdwy = East 1.8'
<u>Mostrom 1991 Survey &amp; LCRC in 3/198</u> Same as above - plus - A.P. = S45°E 35.47' F.P. = S45°W 46.78'			


B. Description of corner evidence found and/or method applied in restoring or reestablishing corner:

Found 3/4" x 12" pipe over pointed stone 15" deep in Mon. box  
 All of the above references were found as typed in bold print.  
 CL asphalt roadway to East is 5' North  
 CL asphalt roadway to West is 27' North

RATIFIED BY PEER GROUP  
 IN ACCORDANCE WITH P.A. 345  
 ON March 13, 2000  
Wayne CO. REPRESENTATIVE

C. Description of monument for corner and accessories established to perpetuate locating the position of the corner:

Set 5/8" x 12" bar with Standard Cap in concrete over stone in Monument Box  
 N & W in Northwest side 6" Fence Post = S45°W 46.78'  
 3" Iron A.P. = S45°E 35.47'  
 Northwest Corner House = S45°E 99.85'  
 36" Maple = S15°E 103.67'  
 Concrete Monument = West 33'

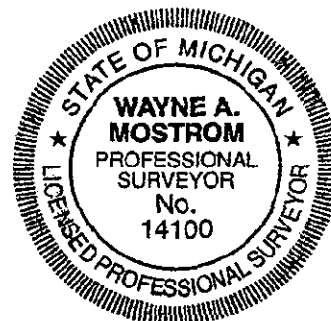

LIBER 6 PAGE 24

Signed by Wayne A. Mostrom Date March 15, 2000  
 Surveyor's Michigan License No. 14100

**REMONUMENTATION**