

LAND CORNER RECORDATION CERTIFICATE
Filing Requirement of Act 74, Mich. P.A. 1970

For corners in Nottawa Township

LIBER 6 PAGE 26

STATE OF MICHIGAN
ST. JOSEPH COUNTY
FILED

29 MAR 2000 10:15:12 AM

CYNTHIA L. JARRATT
REGISTER OF DEEDS

St. Joseph Located In: Corner Code #
(County)

1. Public Land Survey T 6S R 10W C-5
T _____ R _____
T _____ R _____
T _____ R _____ **SURVEY &**
T _____ R _____ **REMONUMENTATION**
2. Property Controlling S _____ T _____ R _____
in Section S _____ T _____ R _____
3. Miscellaneous S _____ T _____ R _____
Property in Sec. S _____ T _____ R _____
JAN 31 2001

Register of Deeds Stamp & File Number

SECTION

4. Lot No. _____, Recorded Plat _____
5. Private Claims _____

I, Wayne A. Mostrom, in a field survey on March 2, 2000 do state that under requirements of P.A. 74, Michigan P.A. of 1970, the corner points mentioned in lines 1 and 2 above were in conformance with regulations and rules therefore as required in the current manual of survey instructions of the United States Department of the Interior, Bureau of Land Management or by a decree of a Court of Law and/or that the corner points mentioned in lines 3, 4 and 5 above were in conformance with the rules of the Michigan Board of Land Surveyors or by a Decree of a Court of Law, established, re-established, monumented, recovered, found as expressed below.

NOTE: Not more than 2 corners, all in the same town and range, may be recorded on this certificate.

1	A	B	C	D	E	F	G	H	I	J	K	L	M
2		6		5		4		3		2		1	
3													
4		7		8		9		10		11		12	
5													
6		18		17		16		15		14		13	
7													
8		19		20		21		22		23		24	
9													
10		30		29		28		27		26		25	
11													
12		31		32		33		34		35		36	
13													

A. Description of original monument and accessories and/or subsequent restoration:

1875 Survey in A/420
12" Hick. = N19°W 1.57 (103.62')
9" Swamp O. = N69°W .65 (42.90')

1911 Survey in 8/457
17" R.O. = S25°W .53 (34.98')
8" W.O. = N80°E 1.06 (69.96')

1974 LCRC in 1/47.
PK in P.P. = SW 51.96'
Shag Bark Tree = SE 41.97'
Box & Notched Stone

1900 Survey in 1/30 & 8/55
Stone
Swamp O. = N70 1/2°W 63 1/3 (41.80')
24" Hick. = N19 3/4°W 1.56 (102.95')

Road Comm. - 1964
Pointed Stone in Mon. Box
34" Hick = N18°W 103.8'
A.P. = S88°E 34.45'
Twin W.O. = S47°W 46.4'

Mostrom 1983 Survey
Notched Stone in Mon. Box
A.P. = West 31.60'
P.P. = SE 56.76' & SW 74.82'


B. Description of corner evidence found and/or method applied in restoring or reestablishing corner:

40" Hick = N19°W 103.62' & 102.96' & 103.8'
A.P. = S88°E 34.45'
36" Twin W.O. = S47°W 46.4'
A.P. = WEST 31.60'
P.P. = SE 56.76'
P.P. = SW 78.82'
Fd. stone in box 30" deep in FL to E&W & in CL rdwy.

RATIFIED BY PEER GROUP
IN ACCORDANCE WITH P.A. 345
ON March 13th, 2000
Wayne CO. REPRESENTATIVE

C. Description of monument for corner and accessories established to perpetuate locating the position of the corner:

Set 5/8" x 24" bar w/std. cap over sto. in Mon. box
N & W in E. side 40" Hick. = N18°W 103.80'
N & W in S. side 6" A.P. = S88°E 34.45'
N & W in S. side 36" Dbl. Oak = S47°W 46.40'
N & W in SW side P.P. = S34°E 56.76'
N & W in NW side P.P. = S30°W 74.82'
1/2" iron bar found = West 32.92'

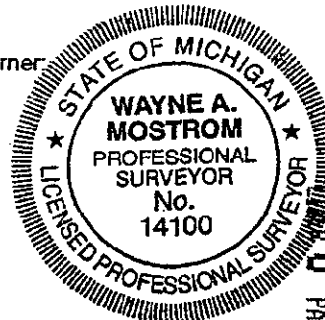

Signed by Wayne A. Mostrom
Surveyor's Michigan License No. 14100

Date March 14, 2000

REMONUMENTATION