

LAND CORNER RECORDATION CERTIFICATE
Filing Requirement of Act 74, Mich. P.A. 1970

For corners in Nottawa Township

St. Joseph County Located In: Corner Code #
(County)

1. Public Land Survey T 6 S R 10 W C-7
 T R
 T R
 T R
 T R
 2. Property Controlling in Section S T R **SURVEY & REMONUMENTATION**
 S T R
 3. Miscellaneous Property in Sec. S T R **JAN 31 2001**
 S T R

LIBER 6 PAGE 37
 STATE OF MICHIGAN
 ST. JOSEPH COUNTY
 FILED

1 MAY 2000 9:38:10 AM

CYNTHIA L. JARRATT
 REGISTER OF DEEDS

Register of Deeds Stamp & File Number

4. Lot No. _____, Recorded Plat _____ SECTION _____
 5. Private Claims _____

I, David W. Mostrom, in a field survey on March 30, 20 00, do state that under requirements of P.A. 74, Michigan P.A. of 1970, the corner points mentioned in lines 1 and 2 above were in conformance with regulations and rules therefore as required in the current manual of survey instructions of the United States Department of the Interior, Bureau of Land Management or by a decree of a Court of Law and/or that the corner points mentioned in lines 3, 4 and 5 above were in conformance with the rules of the Michigan Board of Land Surveyors or by a Decree of a Court of Law, established, re-established, monumented, recovered, found as expressed below.

NOTE: Not more than 2 corners, all in the same town and range, may be recorded on this certificate.

(C-7) CORNER COMMON TO SECTIONS 17, 18, 19, 20 NOTTAWA TOWNSHIP

A. Description of original monument and accessories and/or subsequent restoration:

<u>GLO</u> 15" W. Oak = N70°W 29.04' 14" W. Oak = S75°E 34.32'	<u>1999 Mostrom Survey</u> *Found 1" x 24" Pipe - Set 5/8" x 24" Iron Bar in Pipe & set Monument Box *Road Centerline = South 1± *P. Pole = N48°W 38.25' *P. Pole Pedestal = N43°W 38.48' *SW Cor. Barn = N25°E 33.85' *26" Walnut = S34°W 33.14' *28" Maple = S50°E 42.59'
--	--

1974 LCRC in Book 1, Page 47
 *Found 1 1/2" Iron Pipe
 *18" Oak = SW 32.57' (Walnut)
 *T.P. = NW 38.48'
 *Foundation of Shed = NE 33.81'

B. Description of corner evidence found and/or method applied in restoring or reestablishing corner:


Found 5/8" x 24" iron bar in Monument Box
 Dug 48" below bar but found no record of stone or stake
 SW Corner Barn = N25°E 33.8'
 Hedge Tree = South 39.95'
 26" Walnut = S34°W 33.14'
 P. Pole = N48°W 38.25'
 Centerline Road = South 1.0'
 8" Post = N43°W 38.48'
 28" Maple = S50°E 42.59'
 Corner falls in projection of fence line to the South
 Placed Remon. Cap on Iron

C. Description of monument for corner and accessories established to perpetuate locating the position of the corner:

5/8" x 24" Iron Bar with Standard Cap in Monument Box
 SW Corner Barn = N25°E 33.80'
 N & W 2.0' High in E. Side of 14" Locust = South 39.95'
 N & W 1.0' High in W. Side of 26" Walnut = S34°W 33.14'
 N & W 1.0' High in NE Side of P. Pole = N48°W 38.25'
 N & W 1.0' High in NE Side of 8" Post = N43°W 38.48'
 N & W 2.0' High in NW Side of 28" Maple = S50°W 44.00'

Signed by J. D. W. Mostrom David W. Mostrom Date April 19, 2000
 Surveyor's Michigan License No. 32339

RATIFIED BY PEER GROUP
 IN ACCORDANCE WITH P.A. 345
 ON April 10, 2000
Wm CO. REPRESENTATIVE

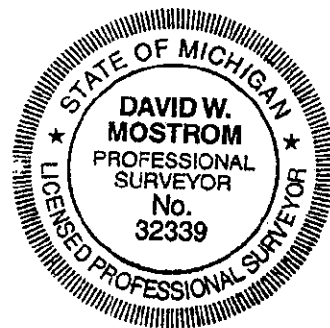

LIBER 6 PAGE 37

REMONUMENTATION