

**LAND CORNER RECORDATION CERTIFICATE**  
**Filing Requirement of Act 74, Mich. P.A. 1970**

For corners in Nottawa Township

St. Joseph County Located in: \_\_\_\_\_ Corner Code # \_\_\_\_\_  
 (County)

1. Public Land Survey T 6S R 10W E-3  
 T \_\_\_\_\_ R \_\_\_\_\_  
 T \_\_\_\_\_ R \_\_\_\_\_ **SURVEY &**  
 T \_\_\_\_\_ R \_\_\_\_\_ **REMONUMENTATION**  
 2. Property Controlling S \_\_\_\_\_ T \_\_\_\_\_  
 in Section S \_\_\_\_\_ T \_\_\_\_\_ R \_\_\_\_\_ **JAN 31 2001**  
 3. Miscellaneous S \_\_\_\_\_ T \_\_\_\_\_  
 Property in Sec. S \_\_\_\_\_ T \_\_\_\_\_ R \_\_\_\_\_  
**SECTION**

4. Lot No. \_\_\_\_\_, Recorded Plat \_\_\_\_\_  
 5. Private Claims \_\_\_\_\_

I, David W. Mostrom, in a field survey on August 9, 20 00, do state that under requirements of P.A. 74, Michigan P.A. of 1970, the corner points mentioned in lines 1 and 2 above were in conformance with regulations and rules therefore as required in the current manual of survey instructions of the United States Department of the Interior, Bureau of Land Management or by a decree of a Court of Law and/or that the corner points mentioned in lines 3, 4 and 5 above were in conformance with the rules of the Michigan Board of Land Surveyors or by a Decree of a Court of Law, established, re-established, monumented, recovered, found as expressed below.

NOTE: Not more than 2 corners, all in the same town and range, may be recorded on this certificate.

(E-3) CORNER COMMON TO SECTIONS 4, 5, 8, 9 NOTTAWA TOWNSHIP

A. Description of original monument and accessories and/or subsequent restoration:

GO  
 8" W. OAK = N39 1/2°W 42.90'  
 18" Y. OAK = S14 1/2°E 67.32'

1904 SURVEY IN BOOK B, PAGE 112  
 \*STONE  
 10" CHERRY = S82 3/4°W 111.54'  
 6" HICKORY = N65 1/4°W 81.18'  
 12" R. OAK = N28 1/4°E 40.26'

1934 SURVEY IN BOOK B, PAGE 560  
 CORNER USED BUT NOT LABELED  
 OR WITNESSED

1960'S ROAD COMMISSION  
 \*+D STONE OVER 2" X 2"  
 STAKE IN MON. BOX  
 \*18" HICKORY = N03°E 67.30'  
 \*15" W. OAK = N24°E 59.05'  
 \*19" W. OAK = N61°E 72.20  
 \*29" CATALPA = SOUTH 24.57'

2000 SURVEY BY MOSTROM  
 \*FOUND STONE IN MON. BOX  
 \*24" HICKORY = N03°E 67.30'  
 \*22" W. OAK = N24°E 59.05'  
 \*24" W. OAK = N61°E 72.20'  
 \*18" CEDAR = S50°W 30.15'  
 \*ANCHOR POST = NORTH 25.58'  
 \*1 1/4" PIPE (6" HIGH) = NORTH 24.68'  
 \*CAPPED IRON = SOUTH 33.00'

B. Description of corner evidence found and/or method applied in restoring or reestablishing corner:

FOUND +D STONE 6" DEEP 2.5' SOUTH OF CENTERLINE BUTLER ROAD (GRAVEL) WITH REMAINS OF STAKE BELOW CORNER FALLS IN LINE W/FENCE PROJ. TO THE NORTH & IS 0.5' WEST OF FENCE PROJ. TO THE SOUTH.  
 ALL WITNESSES FOR 1960'S ROAD COMMISSION AND 2000 SURVEY BY MOSTROM ARE ALL IN AND CHECK O.K.  
 LOWERED STONE & SET 5/8" X 8" WITH IRON BAR WITH STD. CAP IN CONCRETE OVER STONE IN MONUMENT BOX.

C. Description of monument for corner and accessories established to perpetuate locating the position of the corner:


5/8" X 8" IRON BAR WITH STD. CAP IN CONCRETE OVER STONE IN MONUMENT BOX.  
 CAPPED IRON = SOUTH 33.00'  
 24" HICKORY = N03°E 67.30'  
 22" W. OAK = N24°E 59.05'  
 24" W. OAK = N61°E 72.20'  
 18" CEDAR = S50°W 30.15'  
 ANCHOR POST = NORTH 24.68'

Signed by J. D. W. Mostrom David W. Mostrom Date August 15, 2000  
 Surveyor's Michigan License No. 32339

**LIBER 6 PAGE 69**  
 STATE OF MICHIGAN  
 ST. JOSEPH COUNTY  
 FILED  
 18 AUG 2000 10:33:52 AM  
 CYNTHIA L. JARRATT  
 REGISTER OF DEEDS

Register of Deeds Stamp & File Number

1	A	B	C	D	E	F	G	H	I	J	K	L	M
2		6		5		4		3		2		1	
3					●								
4		7		8		9		10		11		12	
5													
6		18		17		16		15		14		13	
7													
8		19		20		21		22		23		24	
9													
10		30		29		28		27		26		25	
11													
12		31		32		33		34		35		36	
13													

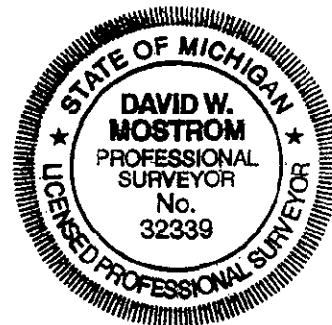

**RATIFIED BY PEER GROUP**  
**IN ACCORDANCE WITH P.A. 345**  
 ON AUG. 14, 2000  
Wasa CO. REPRESENTATIVE

LIBER 6 PAGE 69

**REMONUMENTATION**

69