

**SURVEY &  
REMONUMENTATION**

MAY 07 1997

**LAND CORNER RECORDATION CERTIFICATE**

**COMMISSION Filing Requirement of Act 74, Mich. P.A. 1970**

For corners in  
ST. JOSEPH  
(County)

Located In:

Corner Code #

LIBER 4 PAGE 272

NOTTAWA TWP.

1. Public Land Survey	T	<u>6S</u>	R	<u>10W</u>	<u>G-9</u>
	T		R		
	T		R		
	T		R		
2. Property Controlling in Section	S		T		R
	S		T		R
3. Miscellaneous Property in Section	S		T		R
	S		T		R

STATE OF MICHIGAN  
ST. JOSEPH COUNTY  
FILED

5 DEC 96 12:35 P.M.

CYNTHIA JARRATT  
REGISTER OF DEEDS

Register of Deeds Stamp & File Number

4. Lot No. \_\_\_\_\_, Recorded Plat \_\_\_\_\_  
5. Private Claims \_\_\_\_\_

AUGUST 16, 1995  
NOVEMBER 15, 1996

I, WAYNE A. MOSTROM, in a field survey on \_\_\_\_\_, do hereby certify that under requirements of P.A. 74, Michigan P.A. of 1970, the corner points mentioned in lines 1 and 2 above were in conformance with regulations and rules therefore as required in the current manual of survey instructions of the United States Department of the Interior, Bureau of Land Management or by a decree of a Court of Law and/or that the corner points mentioned in lines 3, 4 and 5 above were in conformance with the rules of the Michigan Board of Professional Surveyors or by a Decree of a Court of Law; established, re-established, monumented, re-monumented, recovered, found as expressed below:

A	B	C	D	E	F	G	H	I	J	K	L	M
2	6	5	4	3	2	1						
3												
4	7	8	9	10	11	12						
5												
6	18	17	16	15	14	13						
7												
8	19	20	21	22	23	24						
9												
10	30	29	28	27	26	25						
11												
12	31	32	33	34	35	36						
13												

NOTE: Not more than 4 corners, all in the same town and range, may be recorded on this certificate.

**A. Description of original monument and accessories and/or subsequent restoration:**

1864 SURVEY IN A/87  
STAKE FROM OLD BEARINGS

1886 SURVEY IN A/530  
SET SASSAFRAS POST IN REMAINS OF ORIGINAL COR. & SURR. IT W/STONES  
18" Y.O. = N69°E 1.02 CH.  
12" BURR O. = N75°E 1.43 CH.

SAYERS 1977 SURVEY & LCRC IN 1/25 BY CHAPP  
IRON PIPE IN MON. BOX  
20" OAK = ENE 91.59'  
P.P. = SSE 118.69'  
T. BEAM FACE = NW 32.53'  
SEE L-374, P-534 FOR CLAPP SURVEY

LCRC IN L-3, P-57 BY MOSTROM  
SAME WITNESSES AS SAYERS 1977 SURVEY

1988 SURVEY BY MOSTROM  
FD. IRON IN MON. BOX  
SAME AS SAYERS 1977 SURVEY


**B. Description of corner evidence found and/or method applied in restoring or reestablishing corner:**

FD. 3/4" X 36" PIPE IN MON. BOX IN CL OF N-S RDWY. COR. IS 2' N. OF CL EAST RDWY'S (ASPHALT) CL GRAVEL RDWY TO W. IS 6' SOUTH

RATIFIED BY PEER GROUP  
IN ACCORDANCE WITH P.A. 345  
ON Nov. 14, 1996  
Wayne CO. REPRESENTATIVE

**C. Description of monument for corner and accessories established to perpetuate locating the position of the corner:**

SET 5/8" X 24" BAR W/STD. COUNTY CAP IN MON. BOX  
TOP OF E. FACE RR RAIL = N48°W 33.60'  
N & W IN NE SIDE P.P. = S53°E 61.74'  
N & W IN SE SIDE P.P. = S21°W 77.69'  
FTDN. @ SE COR. SCHOOL = N75°W 143.96'  
COR. IS IN CL N-S RDWY & IN CL RDWY TO EAST

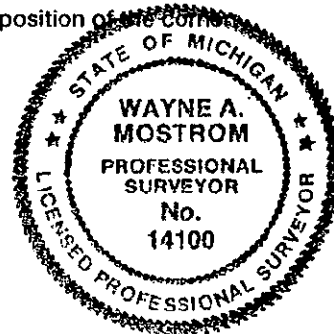

LIBER 4 PAGE 272

Signed by Wayne A. Mostrom

Date NOVEMBER 15, 1996

Surveyor's Michigan License No. 14100

FORM APPROVED BY MICHIGAN STATE BOARD OF PROFESSIONAL SURVEYORS, JAN. 28, 1971  
REVISED MAY 14, 1975  
REVISED JAN., 1983

**REMONUMENTATION**