

LAND CORNER RECORDATION CERTIFICATE
Filing Requirement of Act 74, Mich. P.A. 1970

For corners in Nottawa Twp.

St. Joseph County Located In: _____ Corner Code # _____
(County)

1. Public Land Survey T 6 S R 10 W I-11
 T _____ R _____
 T _____ R _____
 T _____ R _____

2. Property Controlling S _____ T _____ R _____
 in Section S _____ T _____ R _____

3. Miscellaneous S _____ T _____ R _____
 Property in Sec. S _____ T _____ R _____

SURVEY & REMONUMENTATION
JAN 31 2001

4. Lot No. _____, Recorded Plat _____ SECTION _____
 5. Private Claims _____

LIBER **6** PAGE **47**
 STATE OF MICHIGAN
 ST. JOSEPH COUNTY
 FILED

20 JUN 2000 11:18:17 AM

CYNTHIA L. JARRATT
 REGISTER OF DEEDS

Register of Deeds Stamp & File Number

	A	B	C	D	E	F	G	H	I	J	K	L	M
1													
2	6		5		4		3		2		1		
3													
4	7		8		9		10		11		12		
5													
6	18		17		16		15		14		13		
7													
8	19		20		21		22		23		24		
9													
10	30		29		28		27		26		25		
11													
12	31		32		33		34		35		36		
13													

I, Wayne A. Mostrom, in a field survey on May 2, 2000 do state that under requirements of P.A. 74, Michigan P.A. of 1970, the corner points mentioned in lines 1 and 2 above were in conformance with regulations and rules therefore as required in the current manual of survey instructions of the United States Department of the Interior, Bureau of Land Management or by a degree of a Court of Law and/or that the corner points mentioned in lines 3, 4 and 5 above were in conformance with the rules of the Michigan Board of Land Surveyors or by a Decree of a Court of Law, established, re-established, monumented, recovered, found as expressed below.

NOTE: Not more than 2 corners, all in the same town and range, may be recorded on this certificate.

A. Description of original monument and accessories and/or subsequent restoration:

1863 Survey A/38
 Stake with stone placed around it.
 9" Sycamore = N77°E 1.2 ch (79.2')

1960's Road Commission
 Found old wood post at river's edge surrounded by stones -
 Set 1/2" pipe
 Sycamore = N79°E 76.9'
 Tree = S56°E 54.85'
 Boat spike = S83°W (no dist.)
 in CL Nottawa Road

1975 LCRC in 2/37 & 3/58
 Pipe in Mon. box
 Guard Rail = S17°E 53.37'
 Guard Rail = S19°W 53.55'
 Numerous surveys in the area refer to same data as LCRC's

B. Description of corner evidence found and/or method applied in restoring or reestablishing corner:


Found 3/4" x 24" pipe in Mon. box in CL Nottawa Road.
 50' North of bridge. Dug under pipe well into water table and did not find any additional evidence.

Data from 1975 LCRC was in O.K.
 (No occupation to the East or West)

**RATIFIED BY PEER GROUP
 IN ACCORDANCE WITH P.A. 345
 ON JUNE 12, 2000
Wayne CO. REPRESENTATIVE**

C. Description of monument for corner and accessories established to perpetuate locating the position of the corner:

Set 5/8" x 24" Bar and Standard Cap in Monument Box
 3/4" x 24" Pipe = N45°W 30.55'
 3/4" x 24" Pipe = N45°E 37.86'
 N & W in Southeast Side P.P. = S54°W 42.68'
 Notch in Top/Center of "I" Beam Post = S38°W 55.47'
 N & W in Top/Post = S20°W 53.70'
 N & W in Top/Post = S22°E 53.59'

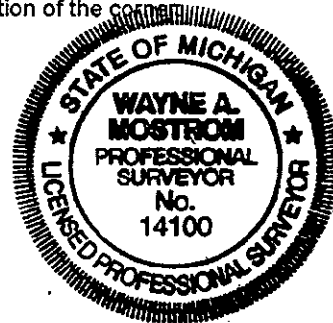

Signed by Wayne A. Mostrom Date June 13, 2000
 Surveyor's Michigan License No. 14100

REMONUMENTATION

LIBER 6 PAGE 47