

**SURVEY &
MONUMENTATION**

JAN 17 1996

LAND CORNER RECORDATION CERTIFICATE
COMMISSION Filing Requirement of Act 74, Mich. P.A. 1970

LIBER 4 PAGE 193

For corners in ST. JOSEPH Located In: _____ Corner Code # _____
(County)

NOTTAWA TWP.

| | | |
|--------------------------------------|--------------------------|------------|
| 1. Public Land Survey | T <u>6S</u> R <u>10W</u> | <u>J-7</u> |
| | T _____ R _____ | _____ |
| | T _____ R _____ | _____ |
| | T _____ R _____ | _____ |
| 2. Property Controlling in Section | S _____ T _____ R _____ | _____ |
| | S _____ T _____ R _____ | _____ |
| 3. Miscellaneous Property in Section | S _____ T _____ R _____ | _____ |
| | S _____ T _____ R _____ | _____ |

4. Lot No. _____, Recorded Plat _____

5. Private Claims _____

STATE OF MICHIGAN
ST. JOSEPH COUNTY
FILED

1 NOV 95 3:10 P.M.

CYNTHIA JARRATT
REGISTER OF DEEDS

Register of Deeds Stamp & File Number

| | | | | | | | | | | | | |
|----|----|----|----|----|----|----|---|---|---|---|---|---|
| A | B | C | D | E | F | G | H | I | J | K | L | M |
| 2 | 6 | 5 | 4 | 3 | 2 | 1 | | | | | | |
| 3 | | | | | | | | | | | | |
| 4 | 7 | 8 | 9 | 10 | 11 | 12 | | | | | | |
| 5 | | | | | | | | | | | | |
| 6 | 18 | 17 | 16 | 15 | 14 | 13 | | | | | | |
| 7 | | | | | | | | | | | | |
| 8 | 19 | 20 | 21 | 22 | 23 | 24 | | | | | | |
| 9 | | | | | | | | | | | | |
| 10 | 30 | 29 | 28 | 27 | 26 | 25 | | | | | | |
| 11 | | | | | | | | | | | | |
| 12 | 31 | 32 | 33 | 34 | 35 | 36 | | | | | | |
| 13 | | | | | | | | | | | | |

I, WAYNE A. MOSTROM, in a field survey on AUGUST, 19 95, do hereby certify that under requirements of P.A. 74, Michigan P.A. of 1970, the corner points mentioned in lines 1 and 2 above were in conformance with regulations and rules therefore as required in the current manual of survey instructions of the United States Department of the Interior, Bureau of Land Management or by a decree of a Court of Law and/or that the corner points mentioned in lines 3, 4 and 5 above were in conformance with the rules of the Michigan Board of Professional Surveyors or by a Decree of a Court of Law; established, re-established, monumented, re-monumented, recovered, found as expressed below:

NOTE: Not more than 4 corners, all in the same town and range, may be recorded on this certificate.

A. Description of original monument and accessories and/or subsequent restoration:

| | | |
|---|-----------------------------|------------------------------|
| <u>1879 SURVEY BY TODD</u> | <u>ROAD COMM. - 1960'S</u> | <u>SAYERS SURVEY OF 1972</u> |
| STAKE FROM REMAINS OF ORIG. BRG. TREES | 1/2" PIPE OVER STONE IN BOX | SEE L-364, P-561 |
| TODD USED COR. IN 1889 (B-A, P-605) BUT SHOWS NO WITNESSES - ALSO SEE BOOK A, P-582 | 26" HICK. = N5°E 29.11' | |
| | 20" CHERRY = N50°E 42.4' | |
| | 22" OAK. = N25°E 21.25' | |

B. Description of corner evidence found and/or method applied in restoring or reestablishing corner:


PIPE, STONE & BOX WERE GRADED OUT BY HEAVY EQUIP.
RESET COR. FROM SAYERS SURVEY RECORDED IN L-375, P-143 BY ANGLE & POST.
SHOWN FROM NW. COR. SEC. RESULTING COR. CHECKS HICK @ N5°E 29.11'
COR. FALLS IN FENCE LINE TO SOUTH & IS 2' SOUTH OF CL GRAVEL RDWY.

**RATIFIED BY PEER GROUP
IN ACCORDANCE WITH P.A. 345
ON Oct. 23, 1995
W.A. Mostrom CO. REPRESENTATIVE**

C. Description of monument for corner and accessories established to perpetuate locating the position of the corner:

SET 5/8"X24" IRON BOX W/STD. CAP IN MON. BOX
26" HICK. = N05°E 29.11'
RR A.P. = NORTH 34.75'
24" HICK. = N70°E 67.54'
10" OAK = S15°E 54.40'
CL OF GRAVEL RDWY. = N. 1.0'

Signed by Wayne A. Mostrom
Surveyor's Michigan License No. 14100

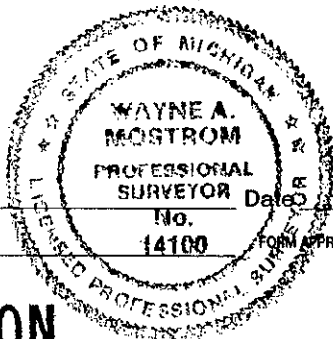

Date OCTOBER 3, 1995

FORM APPROVED BY MICHIGAN STATE BOARD OF PROFESSIONAL SURVEYORS, JAN. 28, 1971
REVISED MAY 14, 1975
REVISED JAN., 1983

544

REMONUMENTATION

LIBER 4 PAGE 193