

**SURVEY &
MONUMENTATION**

JAN 17 1996

COMMISSION LAND CORNER RECORDATION CERTIFICATE
Filing Requirement of Act 74, Mich. P.A. 1970

For corners in
ST. JOSEPH Located In: _____ Corner Code # _____
(County)
NOTTAWA TWP.

1. Public Land Survey	T	<u>6</u>	S	R	<u>10</u>	W	<u>L-7</u>
	T	_____	R	_____	_____	_____	_____
	T	_____	R	_____	_____	_____	_____
	T	_____	R	_____	_____	_____	_____
2. Property Controlling in Section	S	_____	T	_____	R	_____	_____
	S	_____	T	_____	R	_____	_____
3. Miscellaneous Property in Section	S	_____	T	_____	R	_____	_____
	S	_____	T	_____	R	_____	_____

4. Lot No. _____, Recorded Plat _____

5. Private Claims _____

LIBER 4 PAGE 141

STATE OF MICHIGAN
ST. JOSEPH COUNTY
FILED

11 MAY 95 4:23 P.M.

CYNTHIA JARRATT
REGISTER OF DEEDS
Register of Deeds Stamp & File Number

A	B	C	D	E	F	G	H	I	J	K	L	M
2	6		5		4		3		2		1	
3												
4	7		8		9		10		11		12	
5												
6	18		17		16		15		14		13	
7												
8	19		20		21		22		23		24	
9												
10	30		29		28		27		26		25	
11												
12	31		32		33		34		35		36	
13												

I, DAVID W. MOSTROM, in a field survey on APRIL 2, 1995, do hereby certify that under requirements of P.A. 74, Michigan P.A. of 1970, the corner points mentioned in lines 1 and 2 above were in conformance with regulations and rules therefore as required in the current manual of survey instructions of the United States Department of the Interior, Bureau of Land Management or by a decree of a Court of Law and/or that the corner points mentioned in lines 3, 4 and 5 above were in conformance with the rules of the Michigan Board of Professional Surveyors or by a Decree of a Court of Law; established, re-established, monumented, re-monumented, recovered, found as expressed below:

NOTE: Not more than 4 corners, all in the same town and range, may be recorded on this certificate.

A. Description of original monument and accessories and/or subsequent restoration:

(L-7) SOUTH ¼ COR. SEC. 13 NOTTAWA TWP.

1865 SURVEY IN BOOK A, PG. 128

1963 MDOT

STAKE FROM OLD BRG. TREE
12" W. OAK = S02°W 17.82'

SET "T" IRON FROM DOUBLED OVER DISTANCE FROM CORNERS
¼ MILE AND ½ MILE TO EAST
49" WILLOW = N15°W 25.55'
13" CHERRY = S35°E 42.51'
12" HICKORY = SOUTH 41.96'

B. Description of corner evidence found and/or method applied in restoring or reestablishing corner:

(L-7)

FOUND "T" IRON IN MON. BOX AS SET BY MDOT
IRON FALLS 0.21' S. AND 0.21' W. OF DOUBLED OVER DISTANCE FROM CORNERS TO EAST
CHERRY STUMP = S26°E 42.5'±
HICKORY STUMP = S06°E 42'±

RATIFIED BY PEER GROUP
IN ACCORDANCE WITH P.A. 345
ON MAY 8th, 1995
Walter CO. REPRESENTATIVE

C. Description of monument for corner and accessories established to perpetuate locating the position of the corner:

(L-7) SOUTH ¼ COR. SEC. 13 NOTTAWA TWP.


SET 5/8" X 24" IRON BAR W/STD. CAP OVER "T" IRON IN MON. BOX
CORNER FALLS 7.5' SOUTH OF ROAD CENTERLINE AND IN PROJ. OF FENCE TO SOUTH
N & W 6.5' HIGH ON N. SIDE OF 42" WILLOW = S65°E 79.52'
N & W 3.0' HIGH ON W. SIDE OF 14" ELM = S18°E 55.10'
N & W 2.5' HIGH ON W. SIDE OF 10" RED OAK = S05°E 63.74'
N & W 1.5' HIGH ON E. SIDE OF ANCHOR POST = S06°W 27.78'

Signed by [Signature]

Date MAY 10, 1995

Surveyor's Michigan License No. 32339

FORM AP'ROVED BY MICHIGAN STATE BOARD OF PROFESSIONAL SURVEYORS, JAN. 28, 1971
REVISED MAY 14, 1975
REVISED JAN., 1983

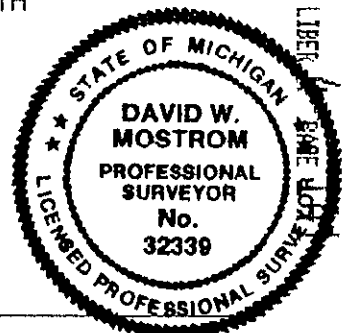

REMONUMENTATION