

NOV 15 1994

LIBER 4 PAGE 62

LAND CORNER RECORDATION CERTIFICATE
Filing Requirement of Act 74, Mich. P.A. 1970

For corners in **COMMISSION**

ST. JOSEPH (County)	Located In:	Corner Code #
NOTTAWA TWP.		
1. Public Land Survey	T 6 S R 10 W	M-5
	T _____ R _____	_____
	T _____ R _____	_____
	T _____ R _____	_____
2. Property Controlling in Section	S _____ T _____ R _____	_____
	S _____ T _____ R _____	_____
3. Miscellaneous Property in Sec.	S _____ T _____ R _____	_____
	S _____ T _____ R _____	_____

STATE OF MICHIGAN
ST. JOSEPH COUNTY
FILED

18 OCT 94 2:29 P.M.

CYNTHIA JARRATT
REGISTER OF DEEDS
Register of Deeds Stamp & File Number

4. Lot No. _____, Recorded Plat _____
5. Private Claims _____

	A	B	C	D	E	F	G	H	I	J	K	L	M
2	6	5	4	3	2	1							
3													
4	7	8	9	10	11	12							
5													
6	18	17	16	15	14	13							
7													
8	19	20	21	22	23	24							
9													
10	30	29	28	27	26	25							
11													
12	31	32	33	34	35	36							
13													

I, DAVID W. MOSTROM, in a field survey on OCTOBER 5, 19 94, do hereby certify that under requirements of P.A. 74, Michigan P.A. of 1970, the corner points mentioned in lines 1 and 2 above were in conformance with regulations and rules therefore as required in the current manual of survey instructions of the United States Department of the Interior, Bureau of Land Management or by a decree of a Court of Law and/or that the corner points mentioned in lines 3, 4 and 5 above were in conformance with the rules of the Michigan Board of Land Surveyors or by a Decree of a Court of Law; established, re-established, monumented, re-monumented, recovered, found as expressed below:

NOTE: Not more than 4 corners, all in the same town and range, may be recorded on this certificate.

A. Description of original monument and accessories and/or subsequent restoration:

(M-5) SE CORNER SEC. 12, T6S, R10W

NO EVIDENCE OF GLO WITNESSES

1974 SURVEY BY PS #14100 &
LCRC IN BK. 3, PG. 54

1961 MDOT

1/2" PIPE OVER LARGE STONE
23" WALNUT = N35°E 49.68'
15" WALNUT = S60°E 35.93'
A.P. = S40°W 41.00'

BOAT SPIKE IN MON. BOX
23" WALNUT = NE 49.68'
15" WALNUT = SE 35.93'
A.P. = SW 41.00'

COLON TWP. COR. = NORTH 74.25', Q HWY = WEST 8.09'

B. Description of corner evidence found and/or method applied in restoring or reestablishing corner:


(M-5)

FOUND BOAT SPIKE IN MON. BOX (NOTHING UNDER BOAT SPIKE)
COLON TWP. COR. = NORTH 74.25'
Q HWY = WEST 8'

RATIFIED BY PEER GROUP
IN ACCORDANCE WITH P.A. 345
ON OCT. 10, 1994
W. W. W. CO. REPRESENTATIVE

C. Description of monument for corner and accessories established to perpetuate locating the position of the corner:

(M-5) SE CORNER SEC. 12, T6S, R10W
SET 5/8" X 24" IRON BAR W/STD. CAP
NW HOUSE COR. = N88°E 111.65'
SW HOUSE COR. = S70°E 118.34'
P. POLE = S22°E 134.20'
SE HOUSE COR. = N56°W 201.78'
COLON TWP. COR. = NORTH 74.25'
Q HWY. = WEST 8'
CORNER FALLS IN PROJ. OF ROAD TO WEST

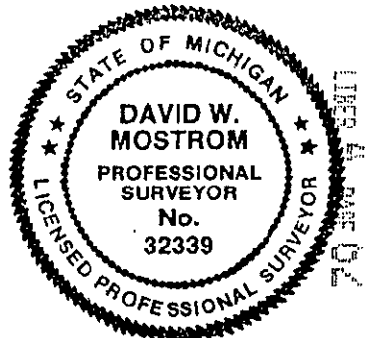

Signed by J. D. W. Mostrom Date OCTOBER 12, 1994
Surveyor's Michigan License No. 32339