

JAN 17 1996

LAND CORNER RECORDATION CERTIFICATE

COMMISSION

Filing Requirement of Act 74, Mich. P.A. 1970

LIBER 4 PAGE 139

For corners in

ST. JOSEPH (County)

Located In:

Corner Code #

NOTTAWA TWP.

- 1. Public Land Survey T 6 S R 10 W M-9
- T _____ R _____
- T _____ R _____
- T _____ R _____
- 2. Property Controlling S _____ T _____ R _____
- in Section S _____ T _____ R _____
- 3. Miscellaneous S _____ T _____ R _____
- Property in Section S _____ T _____ R _____

STATE OF MICHIGAN
ST. JOSEPH COUNTY
FILED

11 MAY 95 4:18 P.M.

CYNTHIA JARRATT
Register of Deeds Stamp & File Number

- 4. Lot No. _____, Recorded Plat _____
- 5. Private Claims _____

A	B	C	D	E	F	G	H	I	J	K	L
2	6	5	4	3	2						
3											
4	7	8	9	10	11	12					
5											
6	18	17	16	15	14	13					
7											
8	19	20	21	22	23	24					
9											
10	30	29	28	27	26	25					
11											
12	31	32	33	34	35	36					
13											

I, DAVID W. MOSTROM, in a field survey on APRIL 7, 1995, do hereby certify that under requirements of P.A. 74, Michigan P.A. of 1970, the corner points mentioned in lines 1 and 2 above were in conformance with regulations and rules therefore as required in the current manual of survey instructions of the United States Department of the Interior, Bureau of Land Management or by a decree of a Court of Law and/or that the corner points mentioned in lines 3, 4 and 5 above were in conformance with the rules of the Michigan Board of Professional Surveyors or by a Decree of a Court of Law; established, re-established, monumented, re-monumented, recovered, found as expressed below:

NOTE: Not more than 4 corners, all in the same town and range, may be recorded on this certificate.

A. Description of original monument and accessories and/or subsequent restoration:

(M-9) SE COR. SEC. 24 NOTTAWA TWP.

1865 SURVEY IN BOOK A, PG. 128

1960 MDOT

SET STAKE 29 LKS. (19.14') SOUTH OF COLON TWP. COR.

CORNER NOT LABELED
FENCE CORNER = N89°W 32.06'
FENCE POST = N35°E 49.86'
STUMP = S60°E 32.84'
COLON TWP. COR. = NORTH 19.11'
HWY. C = EAST 2.08'

B. Description of corner evidence found and/or method applied in restoring or reestablishing corner:

(M-9)

FOUND BOAT SPIKE IN MON. BOX

COLON TWP. COR. (MON. BOX WITH NO CORNER IN IT) = NORTH 19.1'±

CORNER IS IN PROJ. OF FENCE TO WEST

EXISTING HWY. C = EAST 1.8'

RATIFIED BY PEER GROUP
IN ACCORDANCE WITH P.A. 345
ON MAY 8th, 1995
W. Mostrom CO. REPRESENTATIVE

C. Description of monument for corner and accessories established to perpetuate locating the position of the corner:

(M-9)

SET 5/8" X 24" IRON BAR W/STD. CAP IN MON. BOX IN PLACE OF BOAT SPIKE

EXISTING HWY. C = EAST 1.8'


CORNER IS IN PROJ. OF FENCE TO WEST

N & W 2.0' HIGH ON SW SIDE OF P. POLE = N80°E 59.40'

N & W 2.0' HIGH ON N. SIDE OF P. POLE = N88°W 55.13'

N & W 2.0' HIGH ON N. SIDE OF ANCHOR POST = WEST 57.72'

N & W 2.0' HIGH ON SE SIDE OF FENCE POST = S69°W 64.34'

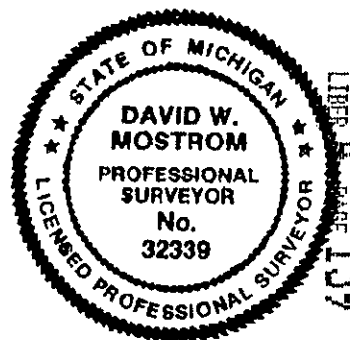

Signed by [Signature]

Date MAY 10, 1995

Surveyor's Michigan License No. 32339