


STATE OF MICHIGAN
DEPARTMENT
OF
NATURAL RESOURCES

LAND CORNER RECORD

I-7

ST JOSEPH COUNTY
T 6S R 11W


DESCRIPTION OF CORNER SE COR, SEC. 15
CORNER MONUMENT MON. BOX 3/4" IRON PIPE
DATE MONUMENT ~~PLACED~~ WITNESSED AUGUST 1969
WITNESSES TO CORNER..... S 70°W 33.4' SOUTHWEST STOP SIGN

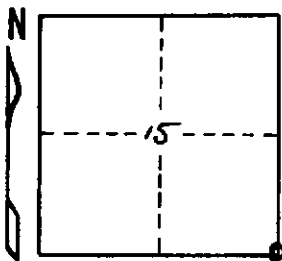

N 45°W 46.2' USGS BENCH MARK
N 40°E 42.2' CORNER FENCE POST PK NAIL & BRASS WASHER
AND
S 70°E 89.7' 10" CMP IN DRIVEWAY

CIRCLE CORNER REGISTERED

DESCRIPTION IN DETAIL AS TO HOW CORNER WAS LOCATED AND IDENTIFIED OR RESTORED.

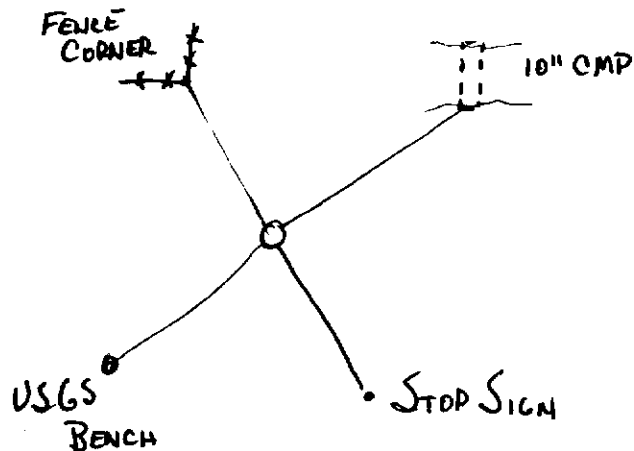

MONUMENT PLACED BY OTHERS

SURVEYOR'S SEAL

DISTRIBUTION:

SIGNED

[Signature]
REGISTERED LAND SURVEYOR

DATE

[Signature]
Aug 69

County Courthouse
Area Forester (Regions I & II)
District or Region Surveyor
Forestry Div., Lansing

R 4047
Rev. 10/68