

STATE OF MICHIGAN
DEPARTMENT
OF
NATURAL RESOURCES

60

LAND CORNER RECORD

F-7


ST. JOSEPH COUNTY
T 65 R 11 W

DESCRIPTION OF CORNER N¹/₄ COR. SEC. 21

CORNER MONUMENT 1/4" IRON ROD

DATE MONUMENT PLACED AND WITNESSED AUGUST 1969

WITNESSES TO CORNER..... N73°30'E 8" OAK 11.0' PK NAIL & BRASS WASHER

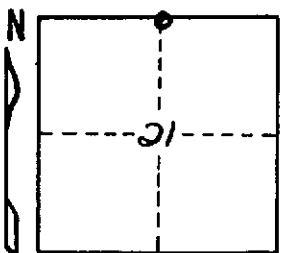

S18°W 18" OAK 39.57' PK NAIL & BRASS WASHER

S82°30'E POWER POLE 32.22' PK NAIL & BRASS WASHER


AND N19°E 12" OAK 28.0' PK NAIL & BRASS WASHER

CIRCLE CORNER REGISTERED

DESCRIPTION IN DETAIL AS TO HOW CORNER WAS LOCATED AND IDENTIFIED OR RESTORED.



IRON SET BY OTHERS

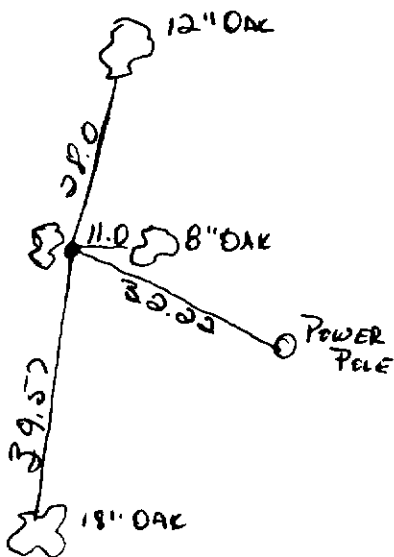

SURVEYOR'S SEAL

SIGNED

[Signature]

DATE

DISTRIBUTION:

REGISTERED LAND SURVEYOR

County Courthouse
Area Forester (Regions I & II)
District or Region Surveyor
Forestry Div., Lansing

R 4047
Rev. 10/68