

STATE OF MICHIGAN  
DEPARTMENT  
OF  
NATURAL RESOURCES

LAND CORNER RECORD

H-7

ST. JOSEPH COUNTY  
T 65 R 11W

DESCRIPTION OF CORNER S 1/4 COR. SEC. 15

CORNER MONUMENT MON. BOX WITH POINTED ROCK


DATE MONUMENT ~~PLACED~~ AND WITNESSED AUGUST 1969

WITNESSES TO CORNER..... N 0° E 26.0' 18" HICKORY PK NAIL & BRASS WASHER

N 52° E 35.3' POWER POLE PK NAIL & BRASS WASHER


S 50° E 49.0' 24" HICKORY PK NAIL & BRASS WASHER

AND

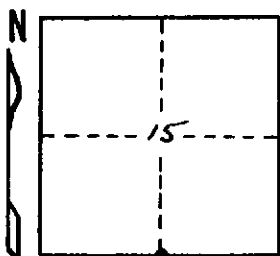

CIRCLE CORNER REGISTERED

DESCRIPTION IN DETAIL AS TO HOW CORNER WAS LOCATED AND IDENTIFIED OR RESTORED.

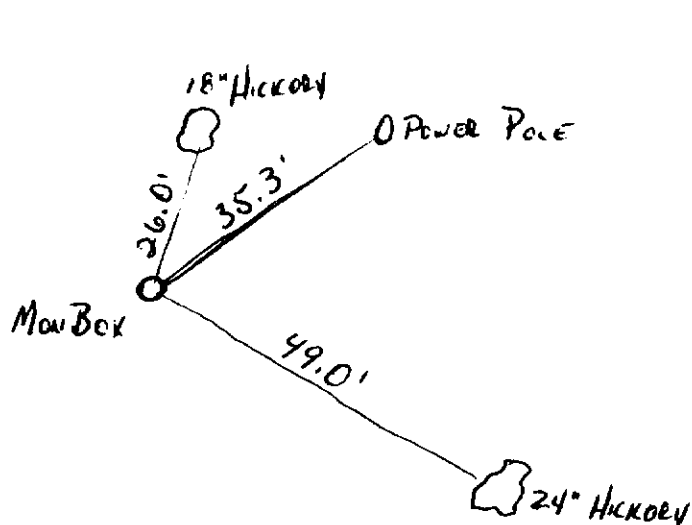

SURVEYOR'S SEAL

SIGNED

*[Signature]*  
REGISTERED LAND SURVEYOR

DATE

Aug 69

DISTRIBUTION:

County Courthouse  
Area Forester (Regions I & II)  
District or Region Surveyor  
Forestry Div., Lansing