

STATE OF MICHIGAN
DEPARTMENT
OF
NATURAL RESOURCES

LAND CORNER RECORD

6-7


ST JOSEPH COUNTY
T 6 S R 11 W

DESCRIPTION OF CORNER NE. Cor. Sec. 21

CORNER MONUMENT 5" PERCO

DATE MONUMENT PLACED AND WITNESSED AUGUST 1969

WITNESSES TO CORNER..... N 85° E 136.35' NW COR BRIDGE RAIL

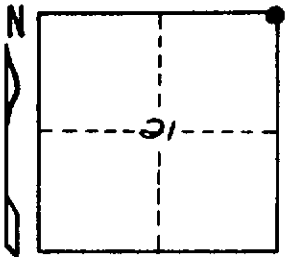

S 85° E 136.35' SW COR BRIDGE RAIL

N 45° E 33.83' PK NAIL & BRASS WASHER


AND

LN POWER POLE

CIRCLE CORNER REGISTERED

DESCRIPTION IN DETAIL AS TO HOW CORNER WAS LOCATED AND IDENTIFIED OR RESTORED.

MON. SET BY OTHERS

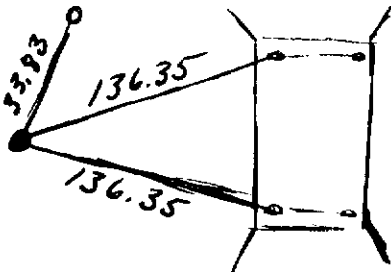

SURVEYOR'S SEAL

SIGNED [Signature] DATE Aug 69
REGISTERED LAND SURVEYOR

DISTRIBUTION:

County Courthouse
Area Forester (Regions I & II)
District or Region Surveyor
Forestry Div., Lansing