

JAN 17 1996

COMMISSION LAND CORNER RECORDATION CERTIFICATE Filing Requirement of Act 74, Mich. P.A. 1970 LIBER 4 PAGE 192

For corners in ST. JOSEPH (County) LOCKPORT TOWNSHIP Located In: Corner Code #

STATE OF MICHIGAN ST. JOSEPH COUNTY FILED 30 OCT 95 8:16 A.M. CYNTHIA JARRATT REGISTER OF DEEDS Register of Deeds Stamp & File Number

- 1. Public Land Survey T 6S R 11W C-13
2. Property Controlling in Section S T R
3. Miscellaneous Property in Section S T R

4. Lot No. , Recorded Plat
5. Private Claims

I, WAYNE A. MOSTROM, in a field survey on OCTOBER 18, 1995, do hereby certify that under requirements of P.A. 74, Michigan P.A. of 1970, the corner points mentioned in lines 1 and 2 above were in conformance with regulations and rules therefore as required in the current manual of survey instructions of the United States Department of the Interior, Bureau of Land Management or by a decree of a Court of Law and/or that the corner points mentioned in lines 3, 4 and 5 above were in conformance with the rules of the Michigan Board of Professional Surveyors or by a Decree of a Court of Law; established, re-established, monumented, re-monumented, recovered, found as expressed below:

Grid table with columns A-M and rows 2-13. A dot is marked in the cell for row 13, column C.

NOTE: Not more than 4 corners, all in the same town and range, may be recorded on this certificate.

A. Description of original monument and accessories and/or subsequent restoration:

1859 SURVEY IN B-A, P-9 "STONE PLANTED" ORIGINAL TREES GLO SURVEY SHOWS NE COR SEC. 6 AS 35 LINKS EAST
1978 SURVEY BY SAYERS STONE IN MON. BOX A.P. = N49°E 67.28' 26" OAK - S64°E 66.3' 14" WAL. = S64°W 44.8'
1990 SURVEY BY MOSTROM FD. STONE IN MON. BOX 15.2' W. OF CL LUTZ RD. SW COR HSE = N47°W 71.89' SE COR HSE = N31°W 57.25'
1979 SURVEY BY SAYERS USED SAME WITNESS AS 1978 SURVEY

B. Description of corner evidence found and/or method applied in restoring or reestablishing corner:


FD. STONE 14" DEEP IN MON. BOX 15.2' WEST OF CL LUTZ RD + 2' S. OF CL E-W RDW'Y'S A.P. = N49°E 67.28' 26" OAK = S64°E 66.3' SW COR HSE = N47°W 71.89' SE COR HSE = N31°W 57.25'

RATIFIED BY PEER GROUP IN ACCORDANCE WITH P.A. 345 ON Oct. 23, 1995 W.A. CO. REPRESENTATIVE

C. Description of monument for corner and accessories established to perpetuate locating the position of the corner:

SET 5/8" X 10" IRON BAR W/STD. CAP IN CONC. IN MON. BOX OVER STONE N & W IN NE. SIDE 28" OAK = S64°E 66.3' SW. COR. HOUSE FTDN. = N47°W 71.89' , SE COR. HSE. = N36°W 57.25' N & W IN E. SIDE 18" WAL. = S06°W 79.64' CL LUTZ RD. = EAST 15.2', CL E-W RDWY = NORTH 2.0'

Signed by Wayne A. Mostrom Date OCTOBER 26, 1995 Surveyor's Michigan License No. 14100

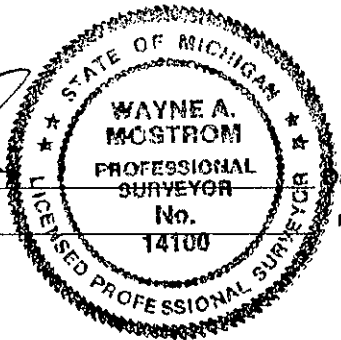

LIBER 4 PAGE 192