

**SURVEY &
MONUMENTATION**

JAN 17 1996

COMMISSION

LAND CORNER RECORDATION CERTIFICATE

Filing Requirement of Act 74, Mich. P.A. 1970

LIBER 4 PAGE 159

For corners in
ST. JOSEPH
(County)

Located In:

Corner Code #

LOCKPORT TWP.

1. Public Land Survey	T	<u>6S</u>	R	<u>11W</u>	<u>D-9</u>
	T	_____	R	_____	_____
	T	_____	R	_____	_____
	T	_____	R	_____	_____
2. Property Controlling in Section	S	_____	T	_____	R
	S	_____	T	_____	R
3. Miscellaneous Property in Section	S	_____	T	_____	R
	S	_____	T	_____	R


STATE OF MICHIGAN
ST. JOSEPH COUNTY
FILED

24 AUG 95 2:18 P.M.

CYNTHIA JARRATT
REGISTER OF DEEDS

Register of Deeds Stamp & File Number

4. Lot No. _____, Recorded Plat _____
5. Private Claims _____

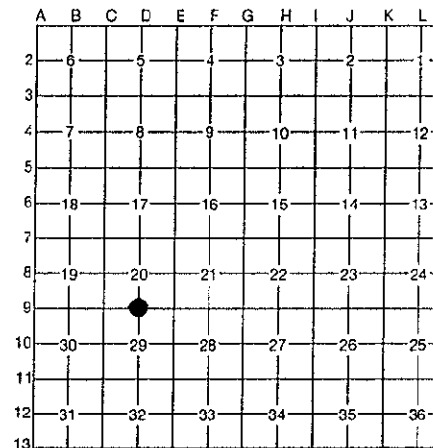

I, WAYNE A. MOSTROM, in a field survey on OCTOBER 18, 19 93, do hereby certify that under requirements of P.A. 74, Michigan P.A. of 1970, the corner points mentioned in lines 1 and 2 above were in conformance with regulations and rules therefore as required in the current manual of survey instructions of the United States Department of the Interior, Bureau of Land Management or by a decree of a Court of Law and/or that the corner points mentioned in lines 3, 4 and 5 above were in conformance with the rules of the Michigan Board of Professional Surveyors or by a Decree of a Court of Law; established, re-established, monumented, re-monumented, recovered, found as expressed below:

NOTE: Not more than 4 corners, all in the same town and range, may be recorded on this certificate.

A. Description of original monument and accessories and/or subsequent restoration:

D-9

<u>1864 SURVEY IN B-A, P-50</u> POST - ORIG. BRG. TREE STILL GROWING 16" W.O = S2°W 30 LKS <u>MOSTROM 1979 SURVEY</u> POINTED STONE IN MON. BOX 30" OAK = SE 36.63' POLE = N. 30.4' 14" MAP. = NW 51.26'	<u>ROAD COMM. - 1960'S</u> STONE/MON. BOX SW COR. HSE = N22°E 84.15' 28" OAK = S25°E 37.7' RR RAIL A.P. = S. 33.8'	<u>L.C.R.C. IN 3/72</u> BOX & STONE R RAIL = SOUTH 33.8' 30" TREE = S20°E 37.2' <u>MOSTROM 1983 SURVEY</u> FD. POINTED STONE IN MON, BOX RRAIL = S. 33.93' 30" OAK = SE 37.13'
--	--	--

B. Description of corner evidence found and/or method applied in restoring or reestablishing corner:

D-9 FOUND POINTED STONE IN MON. BOX 0.5' SOUTH OF CL ASPHALT HWY.
SW. COR. HSE. = N22°E 84.15'
RR RAIL POST = S. 33.8'
POLE = N 30.4'
14" MAPLE = NW 51.26'
COR. IS IN PROJ. OF FENCE TO NORTH
TOP/MON. BOX IS 0.6' BELOW SURFACE

RATIFIED BY PEER GROUP
IN ACCORDANCE WITH P.A. 345
ON Aug. 14, 1995
W.A. Mostrom CO. REPRESENTATIVE

C. Description of monument for corner and accessories established to perpetuate locating the position of the corner:

SET 5/8"X5" BAR WITH STD. CAP IN CONC. OVER STONE IN MON. BOX
SW. COR. HOUSE FTDN. = N22°E 84.15'
CENTER OF RR RAIL @ WEST SIDE = SOUTH 33.8'
N&W IN EAST SIDE TELE. POLE = N4°E 30.4'
N&W IN SW. SIDE 20" MAPLE = N55°W 51.76'
FENCE LINE TO SOUTH = WEST 0.5'
FENCE LINE TO NORTH = WEST 1.0'
CL ASPHALT = NORTH 0.5'



LIBER 4 PAGE 159

Signed by Wayne A. Mostrom

Date AUGUST 23, 1995

Surveyor's Michigan License No. 14100

FORM APPROVED BY MICHIGAN STATE BOARD OF PROFESSIONAL SURVEYORS, JAN. 28, 1971
REVISED MAY 14, 1975
REVISED JAN., 1983

REMONUMENTATION