

RECORD

NOV 04 1997

COMMISSION LAND CORNER RECORDATION CERTIFICATE  
Filing Requirement of Act 74, Mich. P.A. 1970

LIBER 5 PAGE 28

For corners in  
ST. JOSEPH  
 (County)  
LOCKPORT TWP.  
 1. Public Land Survey

Located In:	T 6S R 11W	Corner Code #	E-7
	T R		
	T R		
	T R		
	T R		
2. Property Controlling in Section	S T R		
	S T R		
3. Miscellaneous Property in Sec.	S T R		
	S T R		

STATE OF MICHIGAN  
 ST. JOSEPH COUNTY  
 FILED  
 22 SEP 97 3:26 P.M.  
 CYNTHIA JARRATT  
 REGISTER OF DEEDS

Register of Deeds Stamp & File Number

4. Lot No. \_\_\_\_\_, Recorded Plat \_\_\_\_\_  
 5. Private Claims \_\_\_\_\_

I, WAYNE A. MOSTROM, in a field survey on AUGUST 3, 19 97 do hereby state that under requirements of P.A. 74, Michigan P.A. of 1970, the corner points mentioned in lines 1 and 2 above were in conformance with regulations and rules therefore as required in the current manual of survey instructions of the United States Department of the Interior, Bureau of Land Management or by a decree of a Court of Law and/or that the corner points mentioned in lines 3, 4 and 5 above were in conformance with the rules of the Michigan Board of Land Surveyors or by a Decree of a Court of Law; established, re-established, monumented, recovered, found as expressed below:

NOTE: Not more than 2 corners, all in the same town and range, may be recorded on this certificate.

A	B	C	D	E	F	G	H	I	J	K	L	M
1												
2	6	5		4		3		2		1		
3												
4	7	8		9		10		11		12		
5												
6	18	17		16		15		14		13		
7												
8	19	20		21		22		23		24		
9												
10	30	29		28		27		26		25		
11												
12	31	32		33		34		35		36		
13												

A. Description of original monument and accessories and/or subsequent restoration:

<u>1964 ROAD COMMISSION</u>	<u>1971 SURVEY BY H.D. PIERCE</u>	<u>1976 LCRC IN 3/71</u>	<u>1980 LCRC IN 2/139</u>
1 1/2" PIPE	FOUND 1 1/2" PIPE	FOUND 2" PIPE	IRON PIPE
NW COR HSE=S43°E 202.8'	32" OAK=N70°W 55.6'	12" DBL ELM=NE 80.1'	32" OAK=N70°W 55.6'
NE COR HSE=S47°W 192.75'	TELE POLE=S70°W 73.35'	P. POLE=NW 51.09'	GUARD POST=S24°E 9.1'
16" WILLOW=S14°W 183.8'	PLAT MONUMENT=S35°W 54.78'	EDGE ASPHALT=S. 12.9'	GUARD POST=S56°W 10.29'
P.POLE=S77°W 117.35'			


B. Description of corner evidence found and/or method applied in restoring or reestablishing corner:

FOUND 1 1/2" X 24" PIPE 12" DEEP  
 DUG 4' DEEP & FOUND NO ADD'L EVIDENCE OF CORNER  
 COR IS IN PROJECTED CL OF LAMBERT RD TO S. & RIVER RD. TO WEST  
 COR IS ON SLOPE OF BANK OF ST. JOSEPH RIVER  
 32" OAK = N70°W 55.56' NW COR HSE = S43°E 202.97'  
 EDGE PAV'T - SOUTH 12.5' NE COR HSE = S47°W 193.10'  
 TELE POLE = S70°W 73.35' CORNER CHECKS WITH LOTS IN ST. JOE ACRES NO. 2

RATIFIED BY PEER GROUP  
 IN ACCORDANCE WITH P.A. 345  
 ON AUG. 11, 1997  
Will CO. REPRESENTATIVE

C. Description of monument for corner and accessories established to perpetuate locating the position of the corner:

SET 5/8" X 24" BAR W/STD. CAP  
 NW COR. HOUSE = S43°E 202.90'  
 NE COR. HOUSE = S47°W 193.00'  
 N & W IN S. SIDE 32" OAK = N70°W 55.56'  
 N & W IN TOP GUARD POST = S60°W 10.25'  
 N & W IN N. SIDE P.P. = S70°E 51.09'

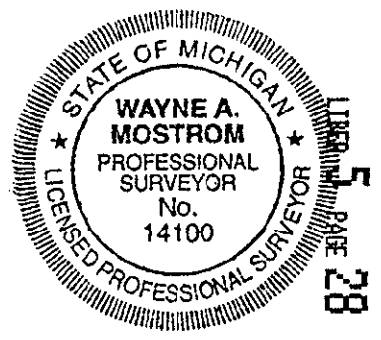

Signed by Wayne A. Mostrom WAYNE A. MOSTROM Date AUGUST 7, 1997  
 Surveyor's Michigan License No. 14100

REMONUMENTATION